
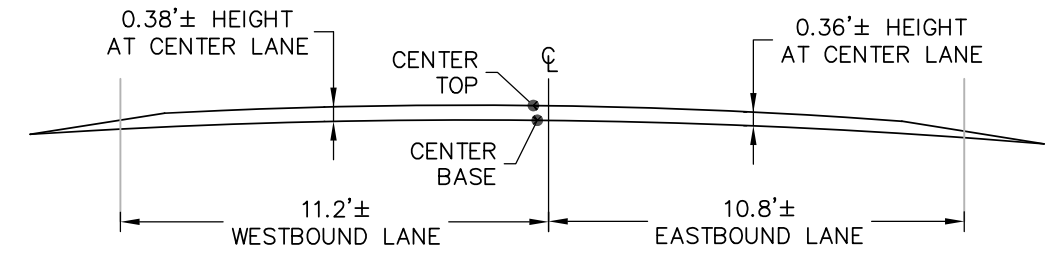



SPEED TABLE 2

- 1.) DATE OF FIELD SURVEY: AUGUST 30, 2021
- 2.) ALL ELEVATIONS SHOWN HEREON ARE ASSUMED


GRAVEL

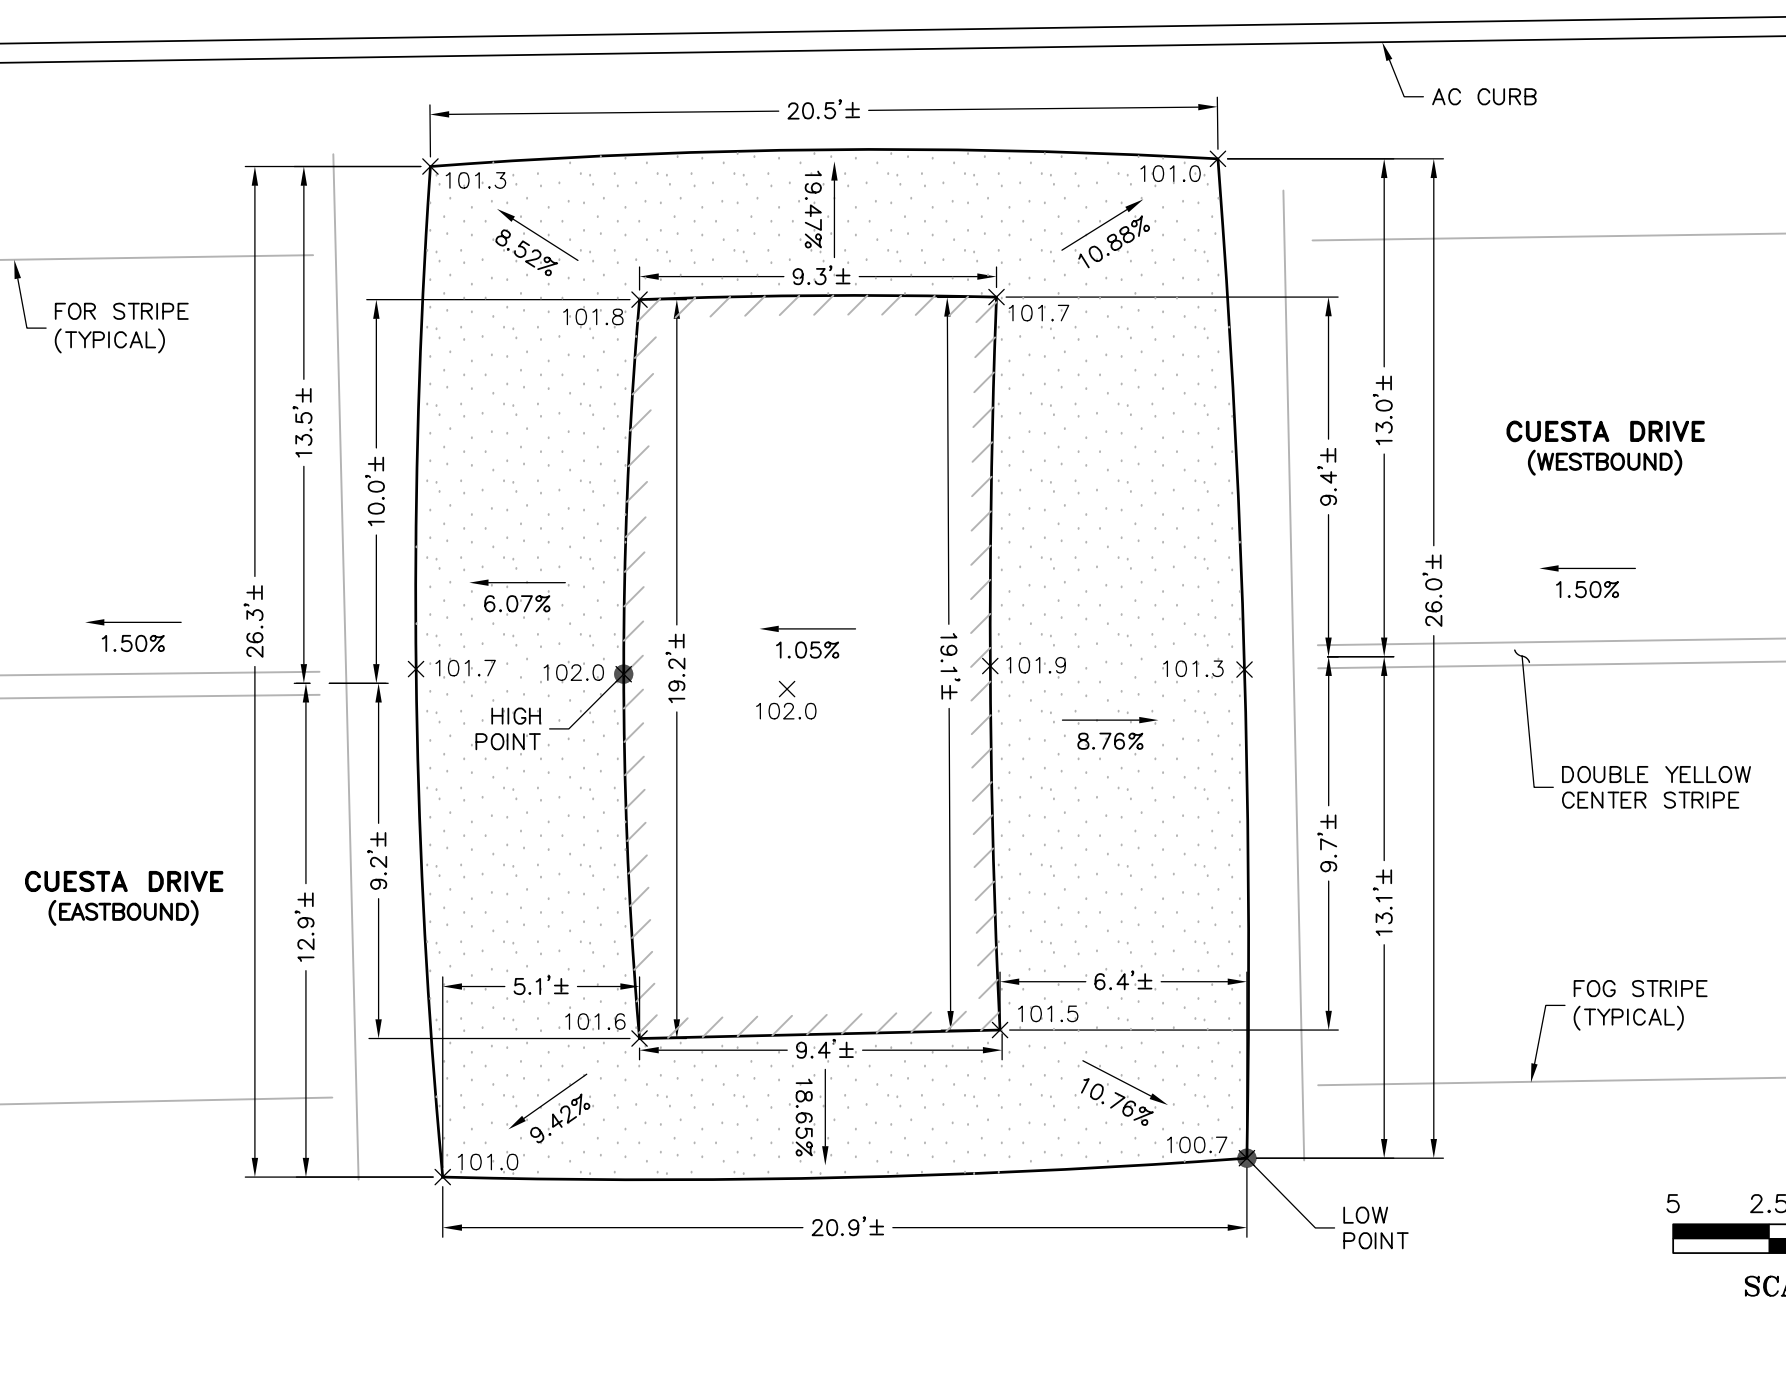


SPEED TABLE 2
DRIVING EAST

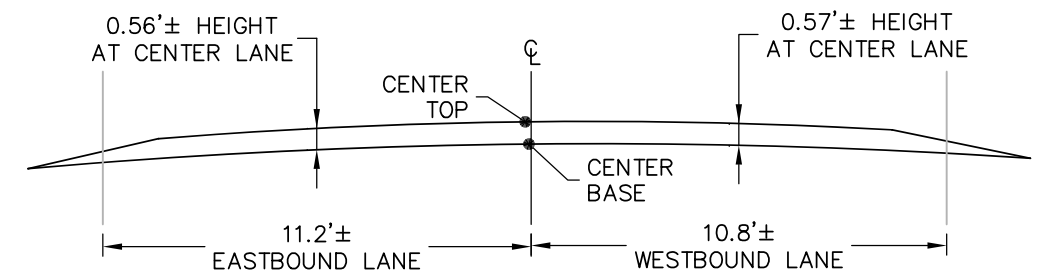

SPEED TABLE 2
DRIVING WEST

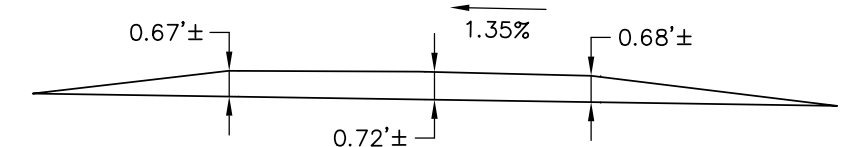


SPEED TABLE 2
SOUTHSIDE LOOKING NORTH

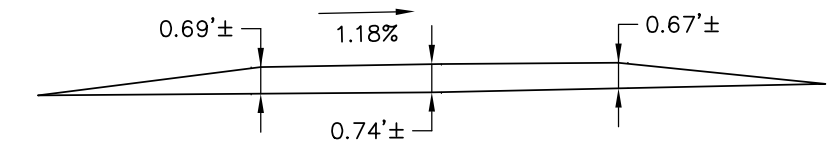

SPEED TABLE 2
NORTHSIDE LOOKING SOUTH

CUESTA DRIVE
(WESTBOUND)

CUESTA DRIVE
(EASTBOUND)

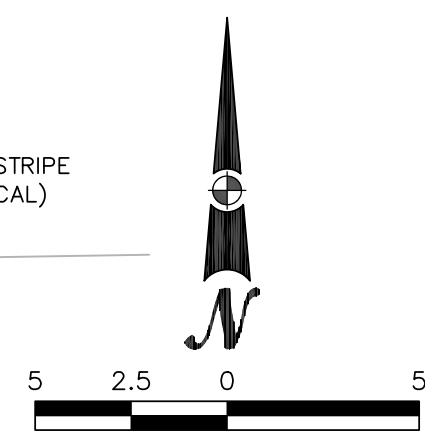

SCALE: 1" = 5'

QUIET RIVER
Land Services Inc.
6747 Sierra Court, Suite K
Dublin, CA 94568
(925) 734-6788 Phone

SPEED TABLE 2 EXHIBIT (2 of 5)

AS-BUILT SURVEY OF 5 SPEED TABLES
NEAR 395 CUESTA DRIVE



LOS ALTOS SANTA CLARA COUNTY CALIFORNIA

TPAT2101 DRN. BY: RO CHK. BY: KMM DATE: 9/7/21


SPEED TABLE 3

- 1.) DATE OF FIELD SURVEY: AUGUST 30, 2021
- 2.) ALL ELEVATIONS SHOWN HEREON ARE ASSUMED


GRAVEL

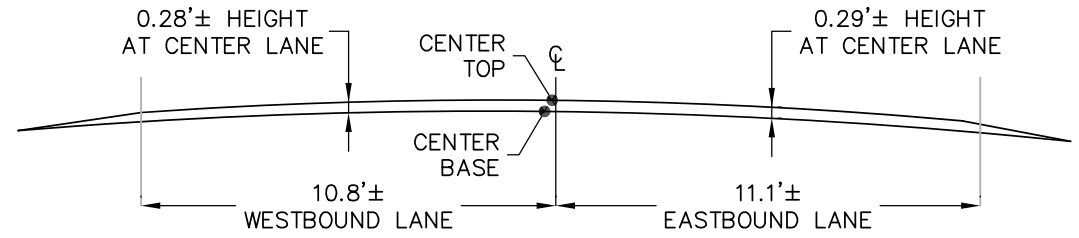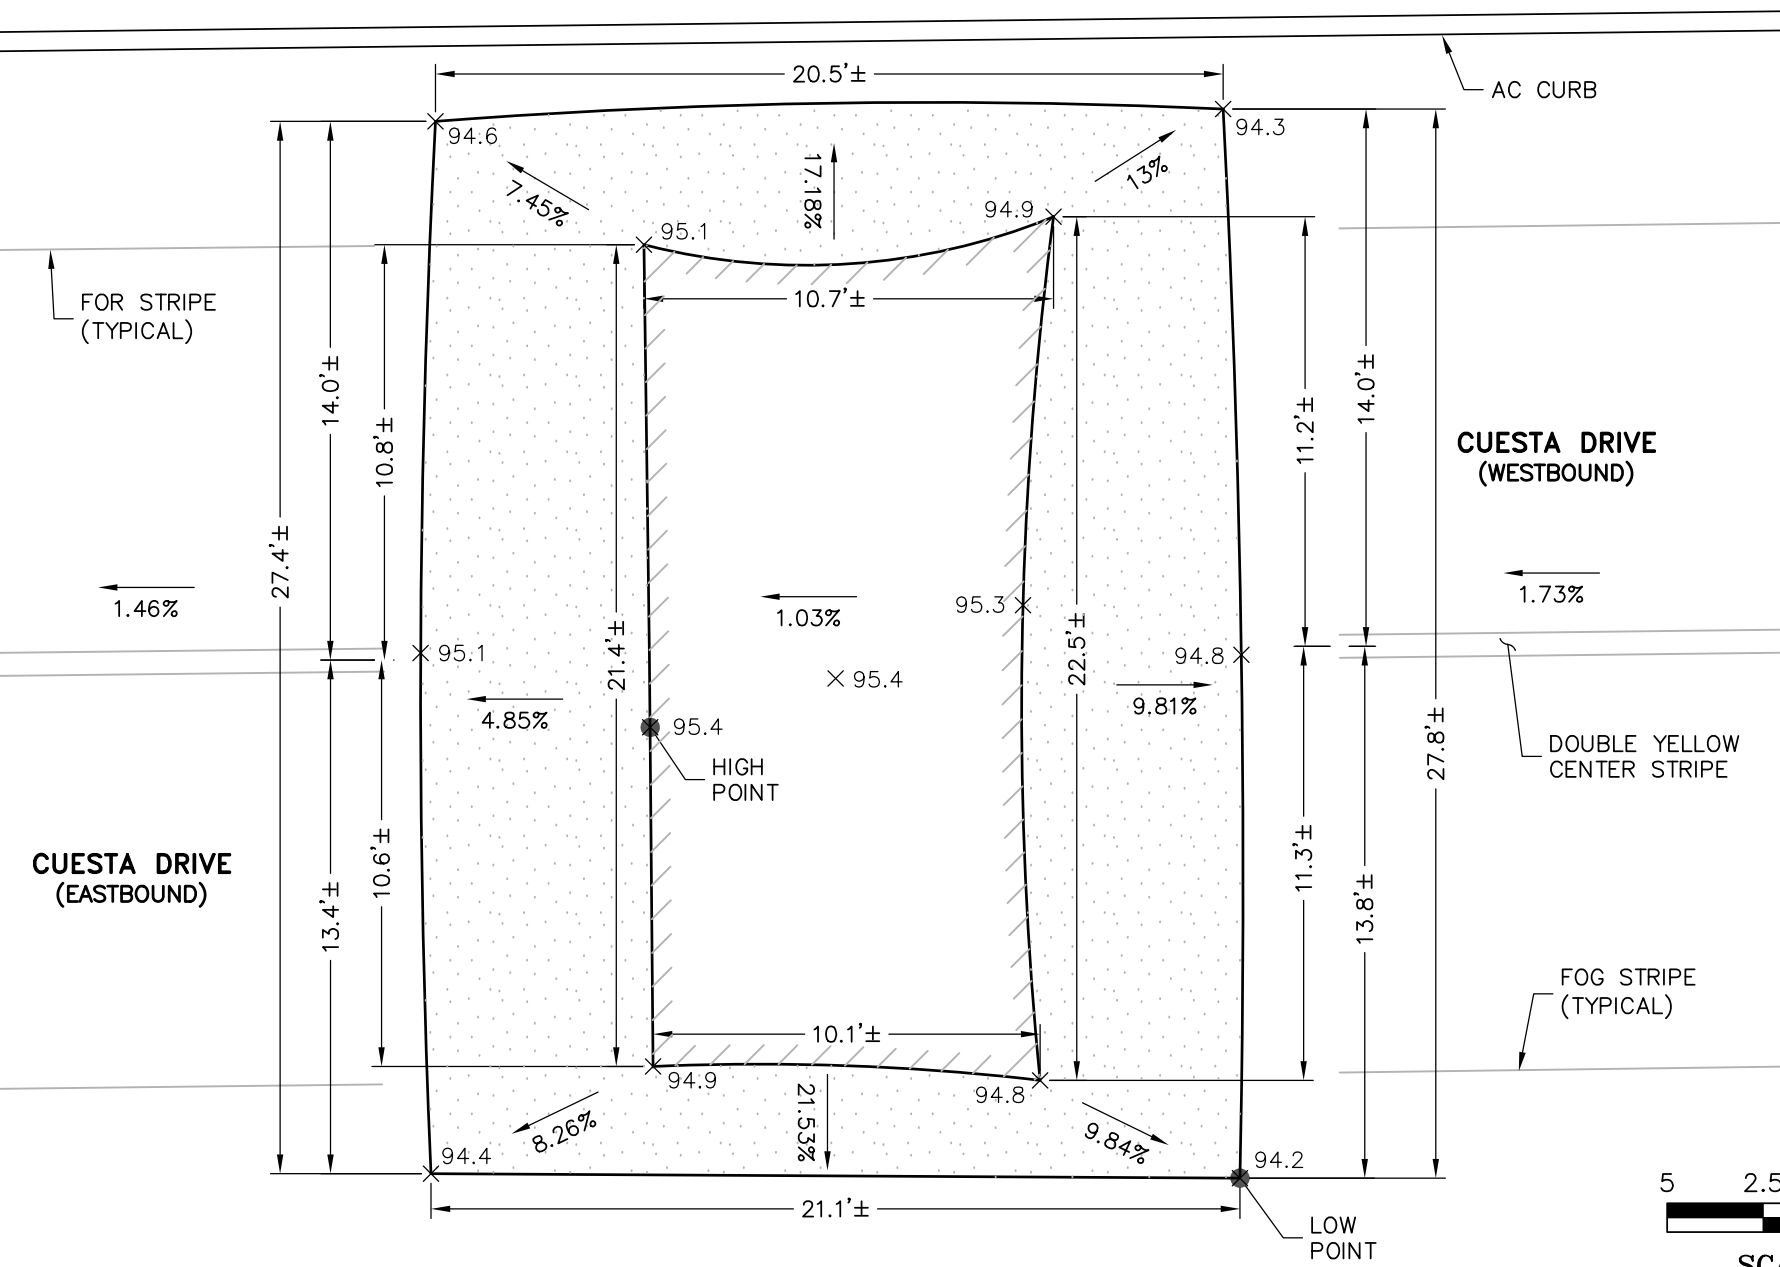


SPEED TABLE 3
DRIVING EAST

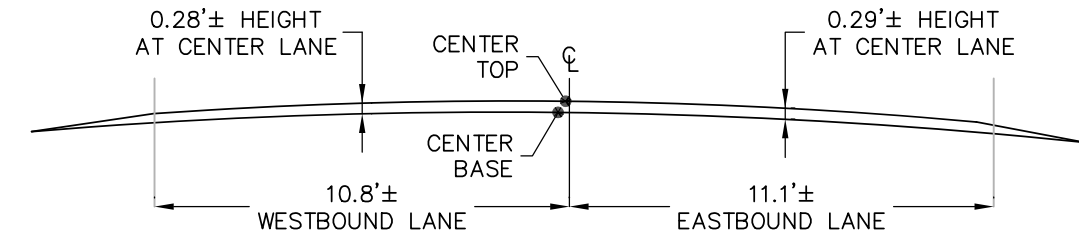


SPEED TABLE 3
DRIVING EAST

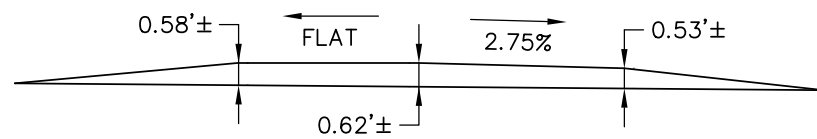

SPEED TABLE 3
SOUTHSIDE LOOKING NORTH

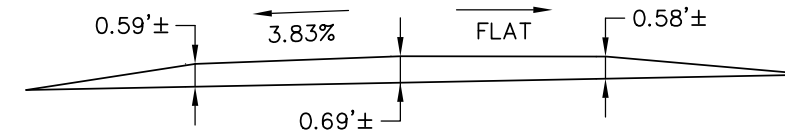

SPEED TABLE 3
NORTHSIDE LOOKING SOUTH

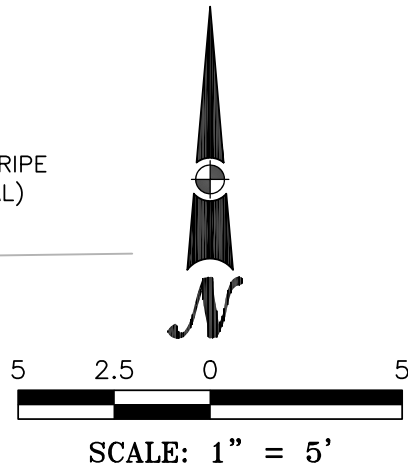



QUIET RIVER
Land Services Inc.
6747 Sierra Court, Suite K
Dublin, CA 94568
(925) 734-6788 Phone

SPEED TABLE 3 EXHIBIT (3 of 5)			
AS-BUILT SURVEY OF 5 SPEED TABLES NEAR 455 CUESTA DRIVE			
LOS ALTOS	SANTA CLARA COUNTY	CALIFORNIA	
TPAT2101	DRN. BY: RO	CHK. BY: KMM	DATE: 9/7/21


SPEED TABLE 4

- 1.) DATE OF FIELD SURVEY: AUGUST 30, 2021
- 2.) ALL ELEVATIONS SHOWN HEREON ARE ASSUMED


GRAVEL

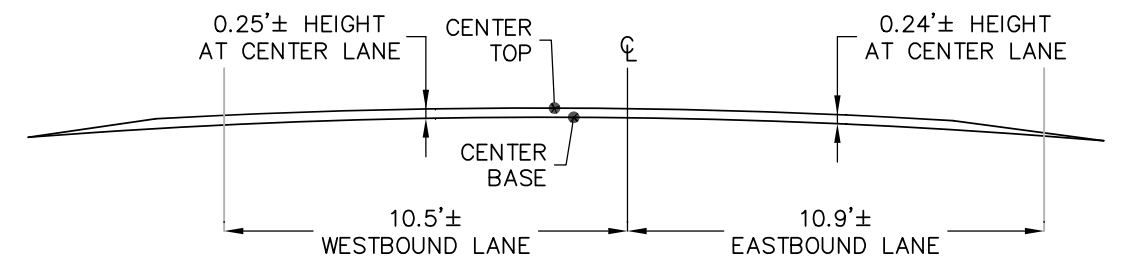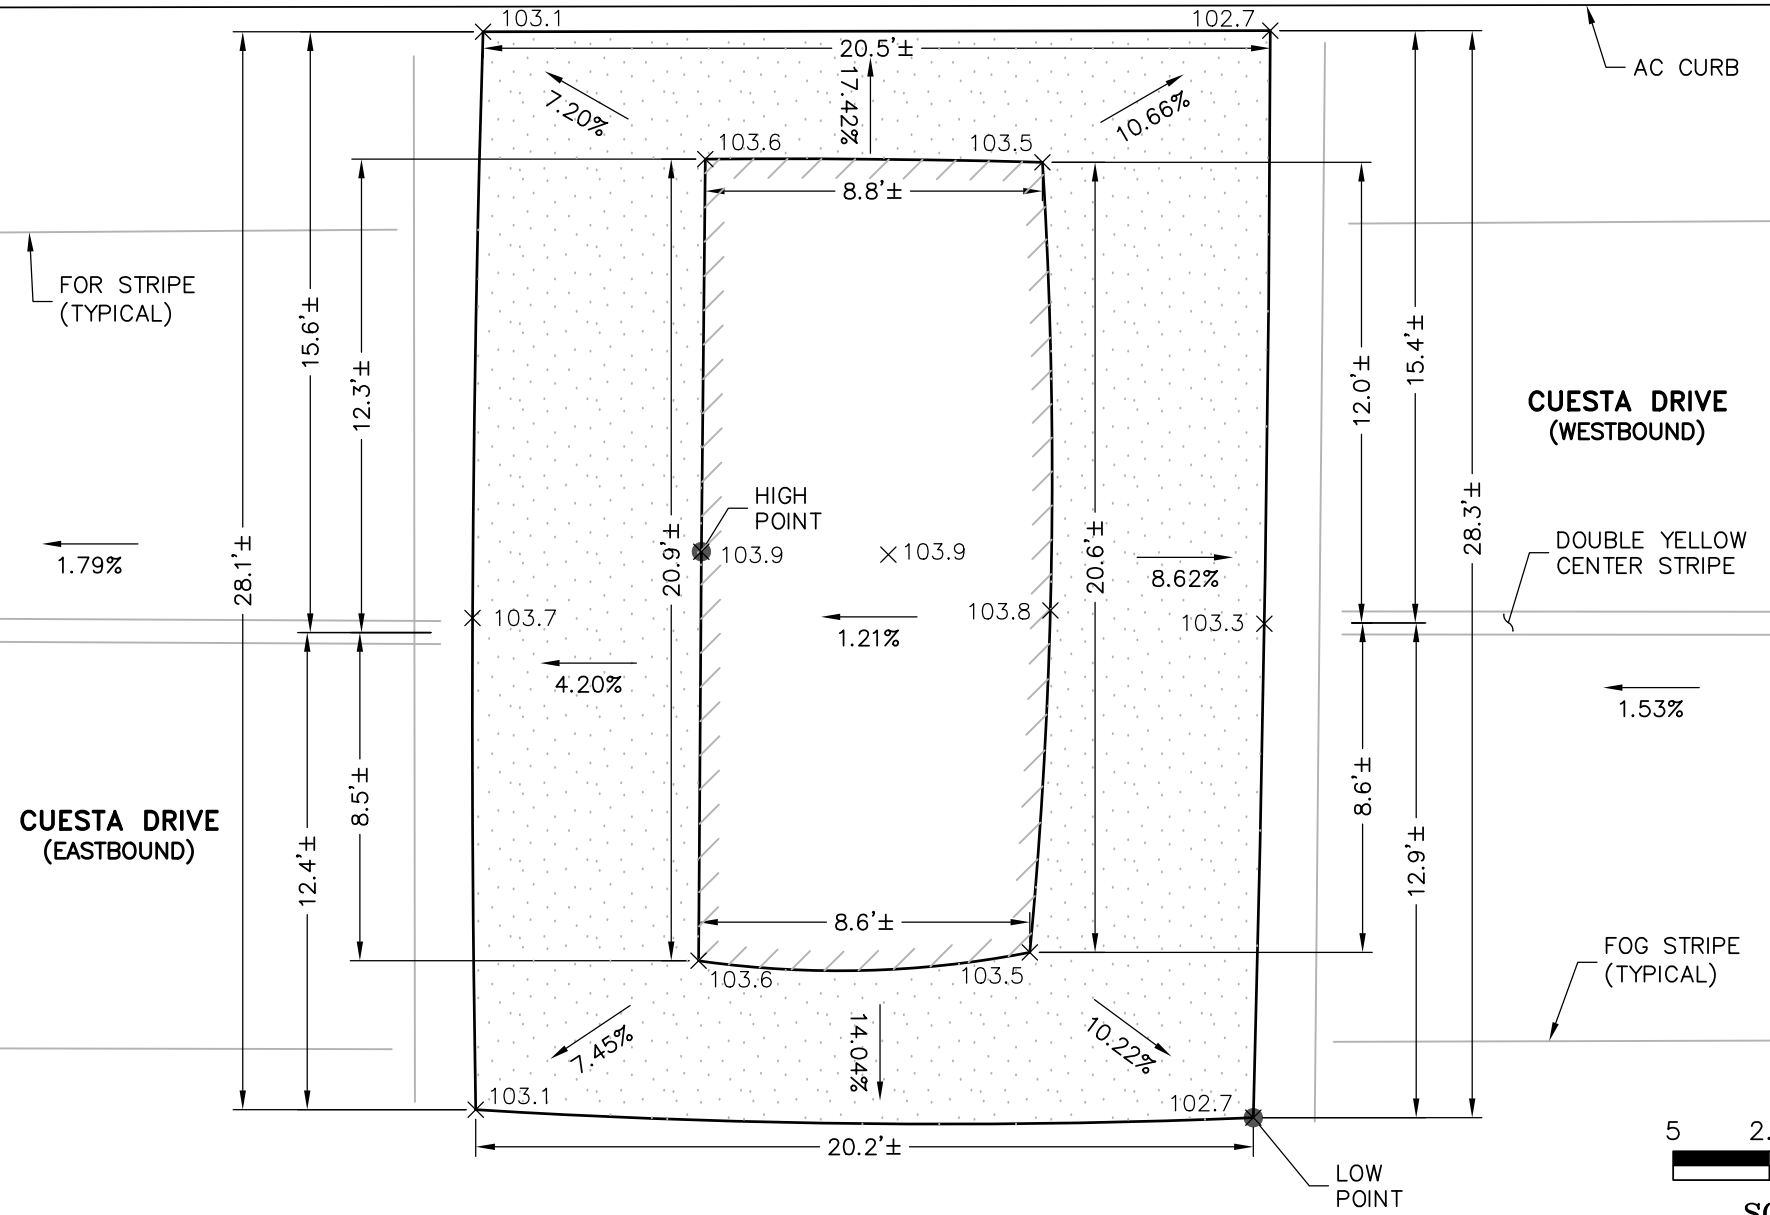


SPEED TABLE 4
DRIVING EAST

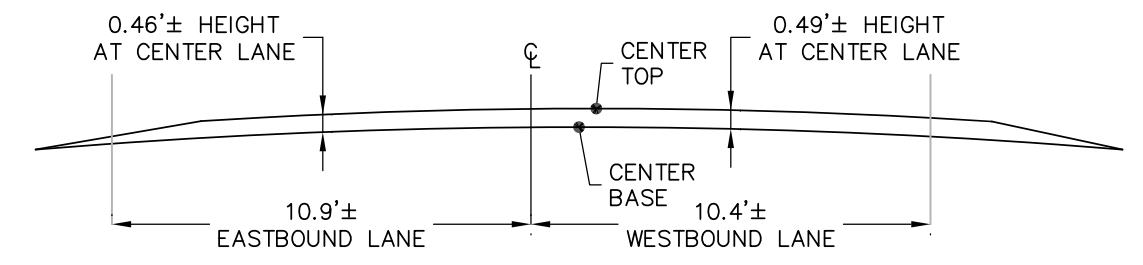


SPEED TABLE 4
DRIVING WEST

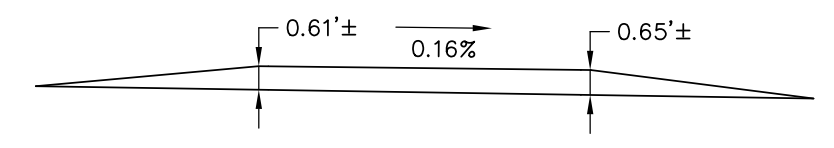

SPEED TABLE 4
SOUTHSIDE LOOKING NORTH

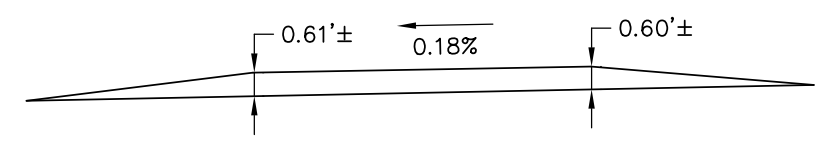

SPEED TABLE 4
NORTHSIDE LOOKING SOUTH

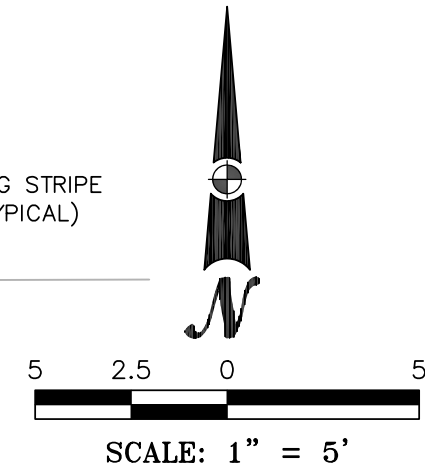

EDGE OF PAVEMENT

QUIET RIVER
Land Services Inc.
6747 Sierra Court, Suite K
Dublin, CA 94568
(925) 734-6788 Phone

SPEED TABLE 4 EXHIBIT (4 of 5)			
AS-BUILT SURVEY OF 5 SPEED TABLES NEAR 621 CUESTA DRIVE			
LOS ALTOS	SANTA CLARA COUNTY	CALIFORNIA	
TPAT2101	DRN. BY: RO	CHK. BY: KMM	DATE: 9/7/21

