PLANS ARE NOT FOR CONSTRUCTION UNLESS APPROVED AND STAMPED BY BUILDING DEPARTMENT

FOR LIVING

DESIGN FOR

P:\21413-Azar\Drawings\CAD\A0.0-Title.dwg - 01.20.2015 - 9:54am

## ABBREVIATIONS

| | | | |
|---|---|---|---|
| & | And | LAB. | Laboratory |
| ∠ | Angle | LAM | Laminate |
| @ | At | LAV. | Lavatory |
| ℄ | Centerline | LKR. | Locker |
| ø | Diameter or Round | LT. | Light |
| ⊥ | Perpendicular | | |
| # | Pound or Number | MAX. | Maximum |
| (E) | Existing | M.C. | Medicine Cabinet |
| | | MECH. | Mechanical |
| ACOUS. | Acoustical | MEMB. | Membrane |
| A.D. | Area Drain | MET. | Metal |
| ADJ. | Adjustable | MFR. | Manufacturer |
| AGGR. | Aggregate | MH. | Manhole |
| AL. | Aluminum | MIN. | Minimum |
| APPROX. | Approximate | MIR. | Mirror |
| ARCH. | Architectural | MISC. | Miscellaneous |
| ASPH. | Asphalt | M.O. | Masonry Opening |
| | | MTD. | Mounted |
| BD. | Board | MUL. | Mullion |
| BITUM. | Bituminous | | |
| BLDG. | Building | N. | North |
| BLK. | Block | N.I.C. | Not In Contract |
| BLKG. | Blocking | NO. or # | Number |
| BM. | Beam | NOM. | Nominal |
| BOT. | Bottom | N.T.S. | Not To Scale |
| CAB. | Cabinet | OA. | Overall |
| C.B. | Catch Basin | OBS. | Obscure |
| CEM. | Cement | O.C. | On Center |
| CER. | Ceramic | O.D. | Outside Diameter (Dim.) |
| C.I. | Cast Iron | OFF. | Office |
| CLG. | Ceiling | OPNG. | Opening |
| CLO. | Closet | OPP. | Opposite |
| CLR. | Clear | | |
| COL. | Column | PRCST. | Pre-cast |
| CONC. | Concrete | PL. | Plate |
| CONN. | Connection | P. LAM. | Plastic Laminate |
| CONSTR. | Construction | PLAS. | Plaster |
| CONT. | Continuous | PLYWD. | Plywood |
| CORR. | Corridor | PR. | Pair |
| CTSK. | Countersunk | PT. | Point |
| CNTR. | Counter | P.T.D. | Paper Towel Dispenser |
| CTR. | Center | P.T.D/R | Combination Paper Towel Dispenser & Receptacle |
| DBL. | Double | PTN. | Partition |
| DEPT. | Department | P.T.R. | Paper Towel Receptacle |
| D.F. | Drinking Fountain | | |
| DET. | Detail | Q.T. | Quarry Tile |
| DIA. | Diameter | | |
| DIM. | Dimension | R. | Riser |
| DISP. | Dispenser | RAD. | Radius |
| DN. | Down | R.D. | Roof Drain |
| D.O. | Door Opening | REF. | Reference |
| DR. | Door | REFR. | Refrigerator |
| DWR. | Drawer | REGTR. | Register |
| DS. | Downspout | REINF. | Reinforced |
| D.S.P. | Dry Standpipe | REQ. | Required |
| DWG. | Drawing | RESIL. | Resilient |
| | | RM. | Room |
| E. | East | R.O. | Rough Opening |
| EA. | Each | RWD. | Redwood |
| E.J. | Expansion Joint | R.W.L. | Rain Water Leader |
| EL. | Elevation | | |
| ELEC. | Electrical | S. | South |
| ELEV. | Elevator | S.C. | Solid Core |
| EMER. | Emergency | S.C.D. | Seat Cover Dispenser |
| ENCL. | Enclosure | SCHED. | Schedule |
| E.P. | Electrical Panelboard | S.D. | Soap Dispenser |
| EQ. | Equal | S.F. | Square Feet |
| EQPT. | Equipment | SECT. | Section |
| E.W.C. | Electric Water Cooler | SH. | Shelf |
| EXST. | Existing | SHR. | Shower |
| EXPO. | Exposed | SHT. | Sheet |
| EXP. | Expansion | SIM. | Similar |
| EXT. | Exterior | S.N.D. | Sanitary Napkin Dispenser |
| | | S.N.R. | Sanitary Napkin Receptacle |
| F.A. | Fire Alarm | SPEC. | Specification |
| F.B. | Flat Bar | SQ. | Square |
| F.D. | Floor Drain | SST. | Stainless Steel |
| FDN. | Foundation | S.SK. | Service Sink |
| F.E. | Fire Extiguisher | STA. | Station |
| F.E.C. | Fire Extinguisher Cabinet | STD. | Standard |
| F.H.C. | Fire Hose Cabinet | STL. | Steel |
| FIN. | Finish | STOR. | Storage |
| FL. | Floor | STRUCT. | Structural or Structure |
| FLASH. | Flashing | SUSP. | Suspended |
| FLUOR. | Fluorescent | SYM. | Symmetrical |
| F.O.C. | Face of Concrete | | |
| F.O.F. | Face of Finish | TRD. | Tread |
| F.O.S. | Face of Studs | T.B. | Towel Bar |
| FPRF. | Fireproof | T.C. | Top of Curb |
| F.S. | Full Size | TEL. | Telephone |
| FT. | Foot or Feet | TER. | Terrazzo |
| FTG. | Footing | T.&G. | Tongue and Groove |
| FURR. | Furring | THK. | Thick |
| FUT. | Future | T.P. | Top of Pavement |
| | | T.P.D. | Toilet Paper Dispenser |
| GA. | Gauge | T.V. | Television |
| GALV. | Galvanized | T.W. | Top of Wall |
| G.B. | Grab Bar | TYP. | Typical |
| GL. | Glass | | |
| GND. | Ground | UNF. | Unfinished |
| GR. | Grade | U.O.N. | Unless Otherwise Noted |
| GYP. | Gypsum | UR. | Urinal |
| H.B. | Hose Bibb | VERT. | Vertical |
| H.C. | Hollow Core | VEST. | Vestibule |
| HDWD. | Hardwood | | |
| HDWE. | Hardware | W. | West |
| HORIZ. | Horizontal | W/ | With |
| HR. | Hour | W.C. | Water Closet |
| HGT. | Height | WD. | Wood |
| | | W/O | Without |
| ID. | Inside Diameter (Dim.) | WP. | Waterproof |
| INSUL. | Insulation | WSCT. | Wainscot |
| INT. | Interior | WT. | Weight |
| JAN. | Janitor | | |
| JT. | Joint | | |
| KIT. | Kitchen | | |

## LEGEND

NORTH ARROW — REF NORTH, TRUE NORTH

DOOR REFERENCE — 101A — DOOR NUMBER (SEE DOOR SCHEDULE)

COLUMN OR GRID LINE — 1 / A — LETTERS LEFT TO RIGHT, NUMBERS TOP TO BOTTOM

WINDOW REFERENCE — A — WINDOW TYPE (SEE WINDOW SCHEDULE)

BUILDING SECTION — A / A4.1 — SECTION IDENTIFICATION; SHEET WHERE SECTION IS SHOWN

LOUVER REFERENCE — L1 — LOUVER TYPE (SEE LOUVER SCHEDULE)

WALL SECTION — D / A4.2 — SECTION IDENTIFICATION; SHEET WHERE SECTION IS SHOWN

CEILING HEIGHTS — +10'-0" — DIMENSION ABOVE DATUM

EXTERIOR ELEVATION — 2 / A5.1 — ELEVATION IDENTIFICATION; SHEET WHERE ELEVATION IS SHOWN

REVISION REFERENCE — 2 — REVISION NUMBER; CLOUD AROUND REVISION

SECTION DETAIL — 4 / A8.2 — DETAIL IDENTIFICATION; SHEET WHERE DETAIL IS SHOWN

WORK, CONTROL, OR DATUM POINT

PLAN DETAIL — 2 / A8.3 — DETAIL IDENTIFICATION; SHEET WHERE DETAIL IS SHOWN

REFERENCE ELEVATION — +10'-0" — DIMENSION ABOVE DATUM

INTERIOR ELEVATION, MULTIPLE VIEWS — 4 A6.1 2 / 3 — ELEVATION IDENTIFICATION; SHEET WHERE ELEVATION IS SHOWN

MATCH LINE — SHADED HALF IS THE SIDE CONSIDERED

INTERIOR ELEVATION, SINGLE VIEW — A6.2 9 — ELEVATION IDENTIFICATION; SHEET WHERE ELEVATION IS SHOWN

CENTER LINE

ROOM IDENTIFICATION — ENTRY 101 — ROOM NAME; ROOM NUMBER

PROPERTY LINE

WALL TYPE — A1 — WALL TYPE IDENTIFICATION

CASEWORK REFERENCE — 09 — CORRESPONDING CASEWORK NUMBER

KEY NOTE — 12 — CORRESPONDING NOTE NUMBER

# AZAR
# RESIDENCE

## 884 HIGHLANDS CIRCLE
## LOS ALTOS, CA 94024

## APPLICABLE CODES

| | |
|---|---|
| 2013 | CALIFORNIA BUILDING CODE (CBC) |
| 2013 | CALIFORNIA REFERENCE STANDARDS CODE (CRSC) |
| 2013 | CALIFORNIA ELECTRICAL CODE (CEC) |
| 2013 | CALIFORNIA MECHANICAL CODES (CMC), |
| 2013 | CALIFORNIA PLUMBING CODE (CPC) |
| 2013 | CALIFORNIA FIRE CODE (CFC) |
| 2010 | CALIFORNIA ENERGY CODE |
| 2013 | CALIFORNIA EXISTING BUILDING CODE (CEBC) |
| 2013 | CALIFORNIA RESIDENTIAL CODE (CRC) |
| 2013 | CALIFORNIA GREEN BUILDING STDS. CODE (CA GREEN) |

## VICINITY MAP

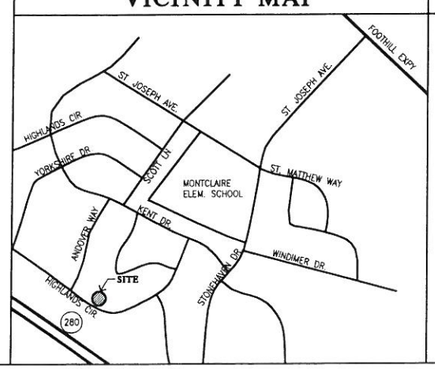


## SHEET INDEX


ARCHITECTURAL

A-0.0 TITLE SHEET
A-1.1 SITE PLAN
A-1.2 PROJECT DATA & AREA CALCS.
A-2.1 LOWER LEVEL FLOOR PLAN
A-2.2 MAIN LEVEL FLOOR PLAN
A-3.1 SECTIONS
A-3.2 SITE SECTIONS
A-4.1 ELEVATIONS
A-5.1 ROOF PLAN
TOPO
L-1 LANDSCAPE PLAN


## PROJECT DIRECTORY


OWNER
SAM AZAR
884 HIGHLANDS CIRCLE
LOS ALTOS, CA 94024

SURVEY
ALPHA LAND SURVEYS, INC
4444 SCOTTS VALLEY DR., #6
SCOTTS VALLEY, CA 95066
(831) 438-4453

ARCHITECT
LOUIE LEU ARCHITECT, INC.
236 N. SANTA CRUZ AVE. SUITE 210
LOS GATOS, CA 95030
(408) 399-2222
LOUIE@LOUIELEUARCH.COM

LANDSCAPE
NATIVE PLANT DESIGN
STEPHANIE MORRIS, LANDSCAPE ARCHITECT
PO BOX 1516
CAMPBELL, CA 95009-1516
(408) 206-5055


## PROJECT DATA

| | |
|---|---|
| ASSESSORS PARCEL NUMBER | 342-11-181 |
| ADDRESS | 884 HIGHLANDS CIRCLE LOS ALTOS, CA 94024 |
| OWNER | SAM AZAR |
| EXISTING USE | RESIDENCE |
| ZONING | R1-10 |
| TOTAL GROSS & NET SITE AREA = | 11,166 SF ± |
| AVERAGE SITE SLOPE | |

ZONING COMPLIANCE

| | EXISTING | PROPOSED | ALLOWED/ REQUIRED |
|---|---|---|---|
| LOT COVERAGE: (LAND THAT IS COVERED BY ALL STRUCTURES THAT ARE OVER 6 FEET IN HEIGHT) | 2,849 SQ. FT. (25.5%) | 3,034 SQ. FT. (27.1%) | 3,350 SQ. FT. (30%) |
| FLOOR AREA: | 3,011.07 SQ. FT. (26.9%) | 3,834.87 SQ. FT. (34.3%) | 3,867 SQ. FT. (34.6%) |
| SETBACKS: | | | |
| FRONT | ±25 FEET | N/C | 25 FEET |
| REAR | ±47'-6" FEET | N/C | 25 FEET |
| RIGHT SIDE | ±23'-9/21'-11" | 17'-6"/17'-6" | 10 FEET/17'-6" |
| LEFT SIDE | ±10 FEET | N/C | 10 FEET |
| HEIGHT: | | N/C | 27 FEET |

SQUARE FOOTAGE BREAKDOWN

| | EXISTING | CHANGE IN | TOTAL PROPOSED |
|---|---|---|---|
| HABITABLE LIVING AREA (INCLUDES HABITABLE BASEMENT AREA) | 2,280.93 SQ. FT. | 912.23 SQ. FT. | 3,193.16 SQ. FT. |
| NON-HABITABLE AREA | 730.14 SQ. FT. | <88.43> SQ. FT. | 641.71 SQ. FT. |

LOT CALCULATIONS

| | | |
|---|---|---|
| NET LOT AREA: | 11,166 SQ. FT. | |
| FRONT YARD HARDSCAPE AREA: | 183.63 SQ. FT. (1.6%) | |
| LANDSCAPE BREAKDOWN: | TOTAL HARDSCAPE AREA (EXISTING & PROPOSED) | 5332.56 SQ. FT. |
| | EXISTING SOFTSCAPE (UNDISTURBED AREA) | 5658.48 SQ. FT. |
| | NEW SOFTSCAPE AREA: | 174.96 SQ. FT. |


LOUIE LEU ARCHITECT, INC.
236 N. Santa Cruz Ave., Suite 210, Los Gatos, Ca 95030
Ph. (408) 399-2222 Fax (408) 399-2223 www.louieleuarch.com


LICENSED ARCHITECT LOUIE LEU No. C15688 31 MAY 2015 RENEWAL DATE STATE OF CALIFORNIA

SIGNATURE DATE

Project No - 21413

AZAR RESIDENCE

884 HIGHLANDS CIRCLE, LOS ALTOS, CA 94024

TITLE SHEET

Scale:- AS NOTED

Date/Revisions:
10-28-14
1 01-13-15 PLAN CHECK COMMENTS

Sheet No:
A-0.0

© 2015-LOUIE LEU ARCHITECT INC.

PLANS ARE NOT FOR CONSTRUCTION UNLESS APPROVED AND STAMPED BY BUILDING DEPARTMENT

DESIGN FOR LIVING

P:\21413-Azar\Drawings\CAD\A1.1 Site Plan.dwg – 01.20.2015 – 9:53am

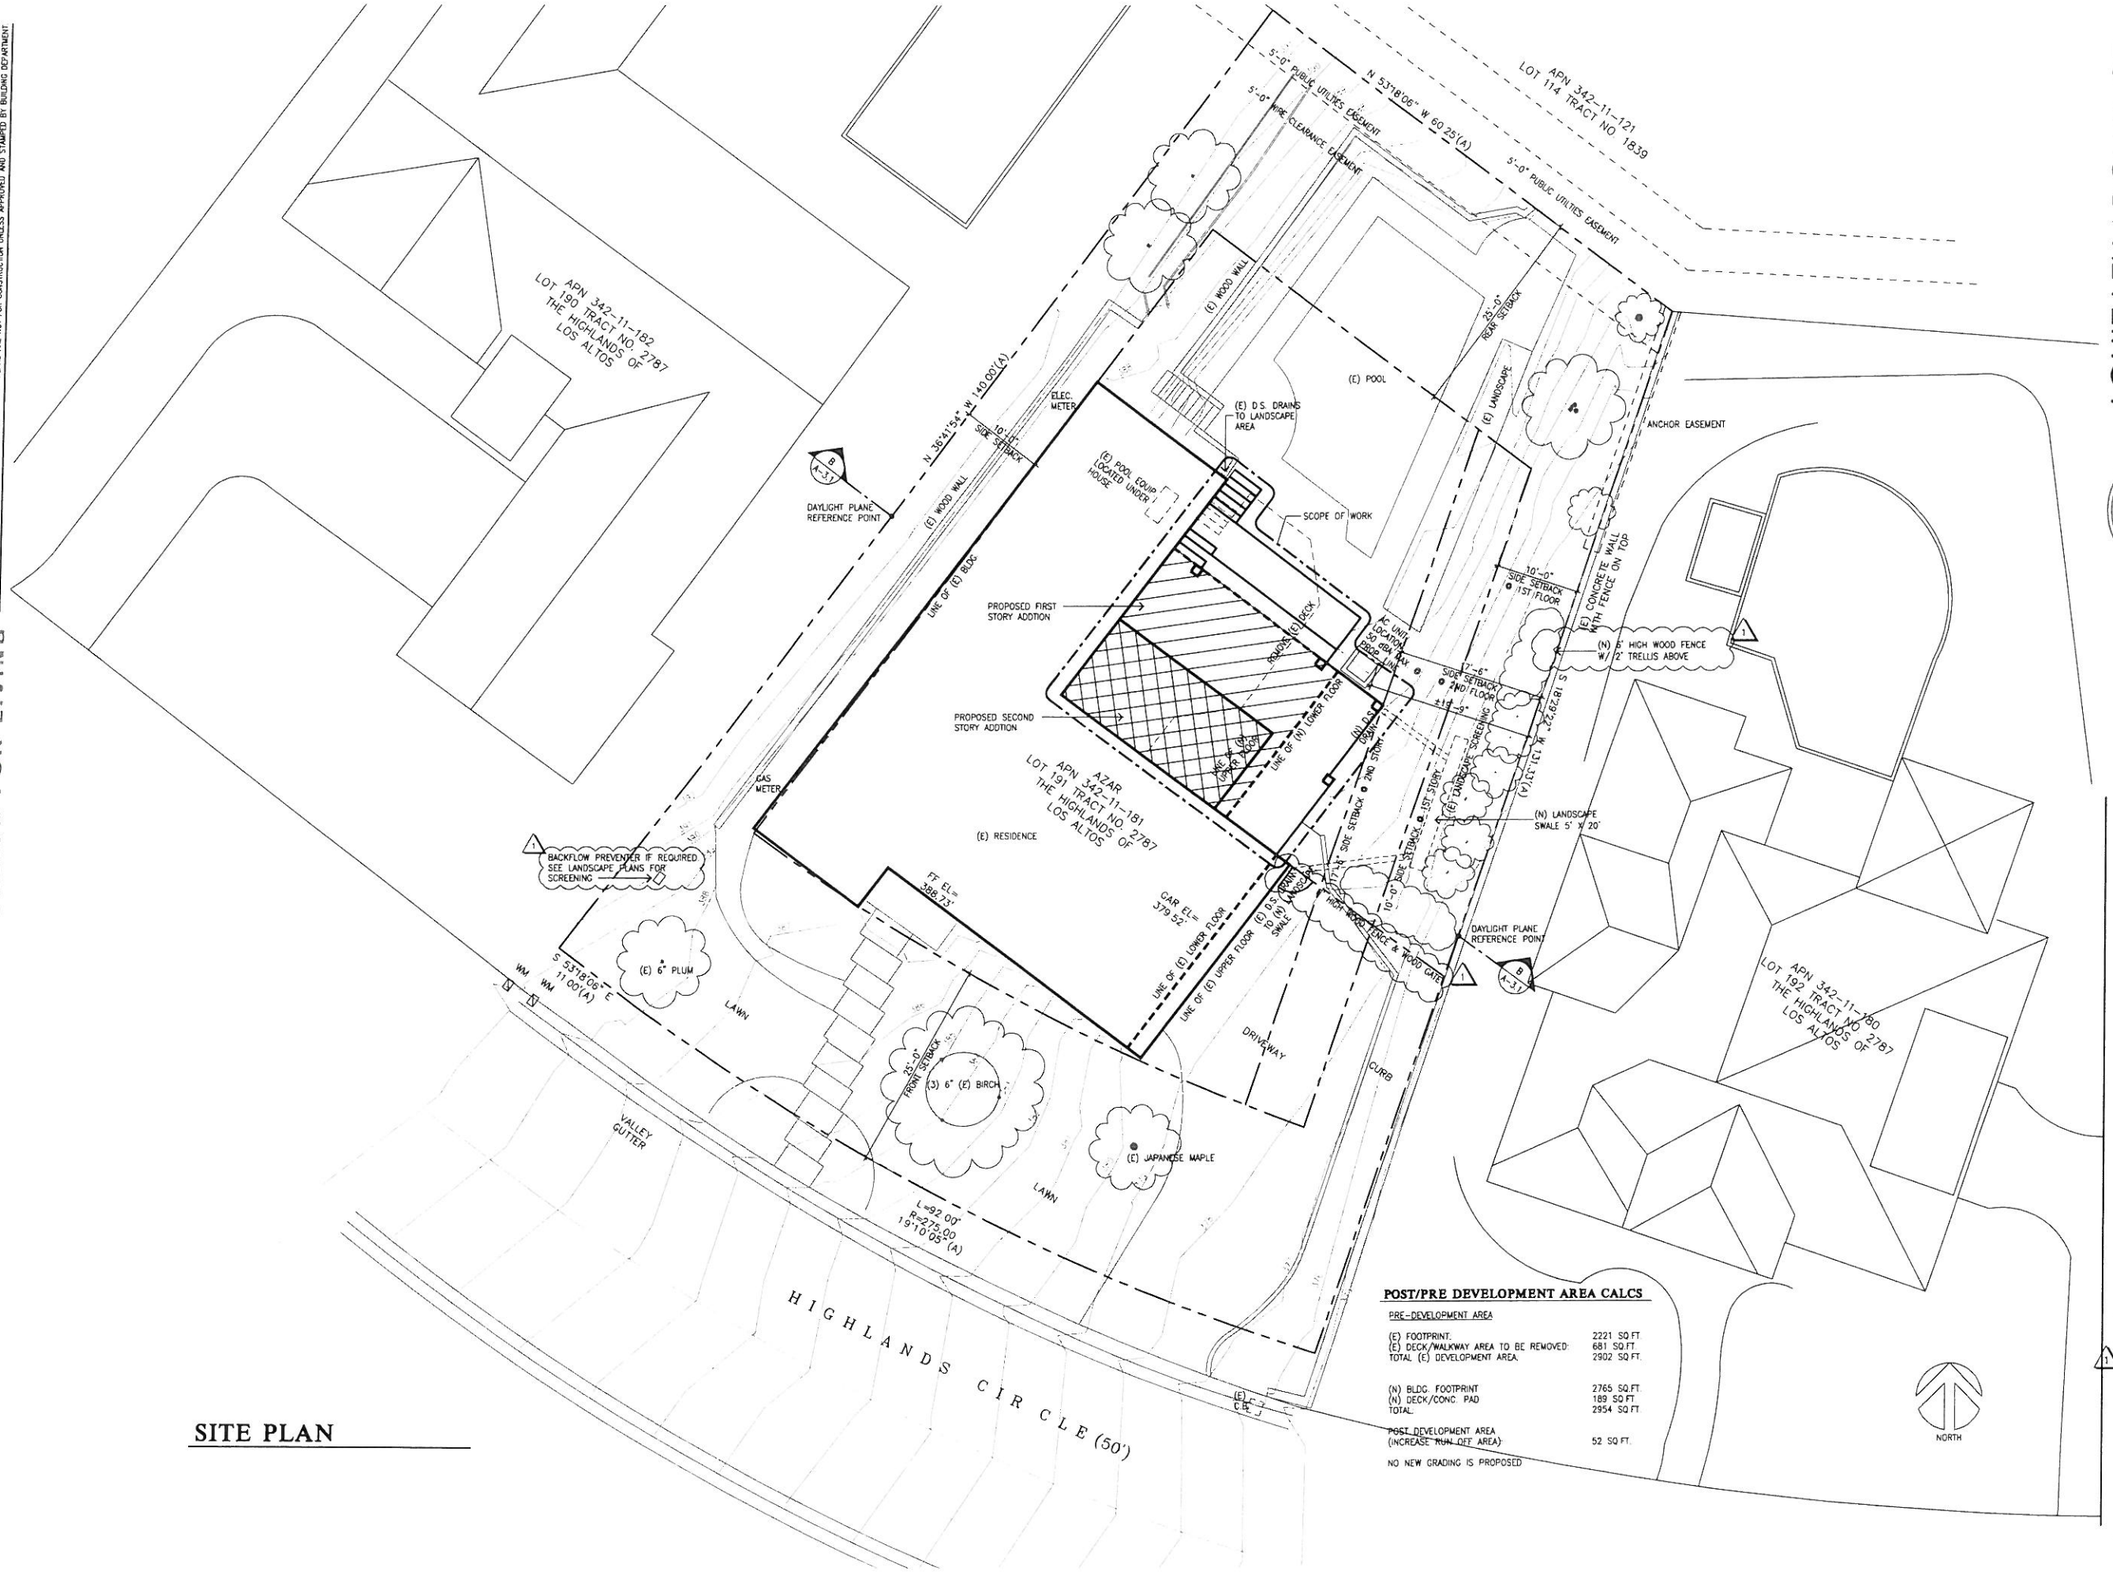


## SITE PLAN

### POST/PRE DEVELOPMENT AREA CALCS

PRE-DEVELOPMENT AREA

| | |
|---|---|
| (E) FOOTPRINT: | 2221 SQ.FT. |
| (E) DECK/WALKWAY AREA TO BE REMOVED: | 681 SQ.FT. |
| TOTAL (E) DEVELOPMENT AREA: | 2902 SQ.FT. |
| (N) BLDG. FOOTPRINT | 2765 SQ.FT. |
| (N) DECK/CONC. PAD | 189 SQ.FT. |
| TOTAL: | 2954 SQ.FT. |
| POST DEVELOPMENT AREA (INCREASE RUN OFF AREA) | 52 SQ.FT. |

NO NEW GRADING IS PROPOSED


LOUIE LEU ARCHITECT INC
236 N. Santa Cruz Ave., Suite 210, Los Gatos, Ca 95030
Ph. (408) 399-2222 Fax (408) 399-2223 www.louieleuarch.com


LICENSED ARCHITECT LOUIE LEU No. C15688 31 MAY 2015 RENEWAL DATE STATE OF CALIFORNIA

SIGNATURE DATE

Project No - 21413

# AZAR RESIDENCE

884 HIGHLANDS CIRCLE, LOS ALTOS, CA 94024

SITE PLAN

Scale - 1/8" = 1'-0"

Date/Revisions:
10-28-14
1 01-13-15 PLAN CHECK COMMENTS

Sheet No.
A -1.1

© 2015-LOUIE LEU ARCHITECT INC.

PLANS ARE NOT FOR CONSTRUCTION UNLESS APPROVED AND STAMPED BY BUILDING DEPARTMENT

DESIGN FOR LIVING

P:\21413-Azar\Drawings\CAD\A1_Area Calcs.dwg - 01.20.2015 - 9:55am

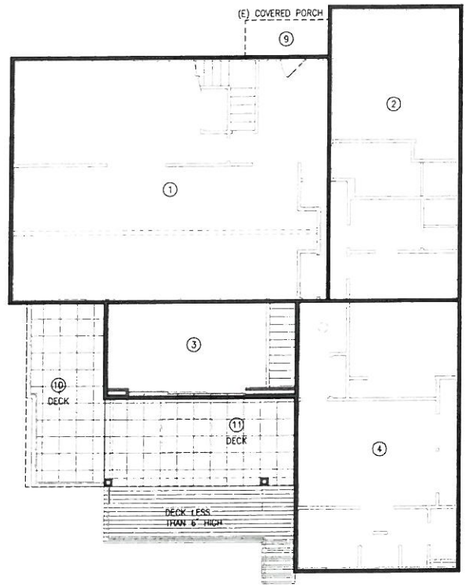


## MAIN LEVEL FLOOR PLAN

1/8" = 1'-0"

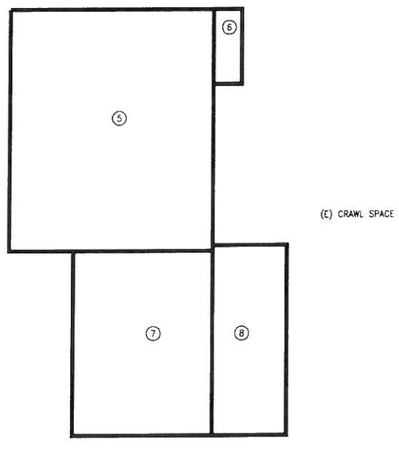


## BASEMENT LEVEL FLOOR PLAN

1/8" = 1'-0"

## AREA CALCULATIONS

| TAG # | CALCULATION | AREA |
|---|---|---|
| | **MAIN LEVEL FLOOR AREA** | |
| 1 | 38'-0" x 29'-0" | 1,102.00 SQ. FT. |
| 2 | 15'-9" x 34'-11" | 549.93 SQ. FT. |
| 3 | 22'-11-1/2" x 11'-4-1/2" | 261.15 SQ. FT. |
| 4 | 19'-5-1/2" x 32'-3" | 627.53 SQ. FT. |
| | **SUB-TOTAL (MAIN LEVEL)** | **2,540.61 SQ. FT.** |
| | | |
| | **LOWER LEVEL FLOOR AREA** | |
| 5 | 24'-1-1/2" x 29'-0" | 699.62 SQ. FT. |
| 6 | 3'-4 1/2" x 9'-0-1/2" | 30.51 SQ. FT. |
| 7 | 16'-6-1/2" x 22'-0" | 363.91 SQ. FT. |
| 8 | 8'-10" x 22'-8" | 200.22 SQ. FT. |
| | **SUB-TOTAL (LOWER LEVEL)** | **1,294.26 SQ. FT.** |
| | **TOTAL FLOOR AREA PROPOSED** | **3,834.87 SQ. FT.** |
| | | |
| | **MAXIMUM FLOOR AREA ALLOWED** | **3,869 SQ. FT.** |
| | | |
| | **STRUCTURES OVER 6'-0" HIGH** | |
| 9 | 10'-2" x 4'-4-1/2" (EXISTING FRONT PORCH) | ±44.47 SQ. FT. |
| 10 | 9'-4" x 22'-0" | 205.33 SQ. FT. |
| 11 | 22'-11-1/2" x 10'-7-1/2" | 243.93 SQ. FT. |
| | **SUB-TOTAL** | **493.73 SQ. FT.** |
| | MAIN LEVEL FLOOR AREA FOOTPRINT | 2,540.61 SQ. FT. |
| | **TOTAL LOT COVERAGE** | **3,034.34 SQ. FT.** |
| | | |
| | **EXISTING DECK TO BE REMOVED** | **±522.79 SQ. FT.** |


LOUIE LEU ARCHITECT INC

236 N Santa Cruz Ave., Suite 210, Los Gatos, Ca 95030

Ph. (408) 368-9999 Fax (408) 368-9998 www.louieleuarch.com


LICENSED ARCHITECT * LOUIE LEU * No. C15688 * STATE OF CALIFORNIA

31 MAY 2015 RENEWAL DATE

PLOT DATE

Project No. - 21413

# AZAR RESIDENCE

884 HIGHLANDS CIRCLE, LOS ALTOS, CA 94024

## AREA CALCULATIONS & PROJECT DATA

Scale AS NOTED

Date/Revisions:
10-28-14

Sheet No

A - 1.2


©2015-LOUIE LEU ARCHITECT INC

PLANS ARE NOT FOR CONSTRUCTION UNLESS APPROVED AND STAMPED BY BUILDING DEPARTMENT

DESIGN FOR LIVING

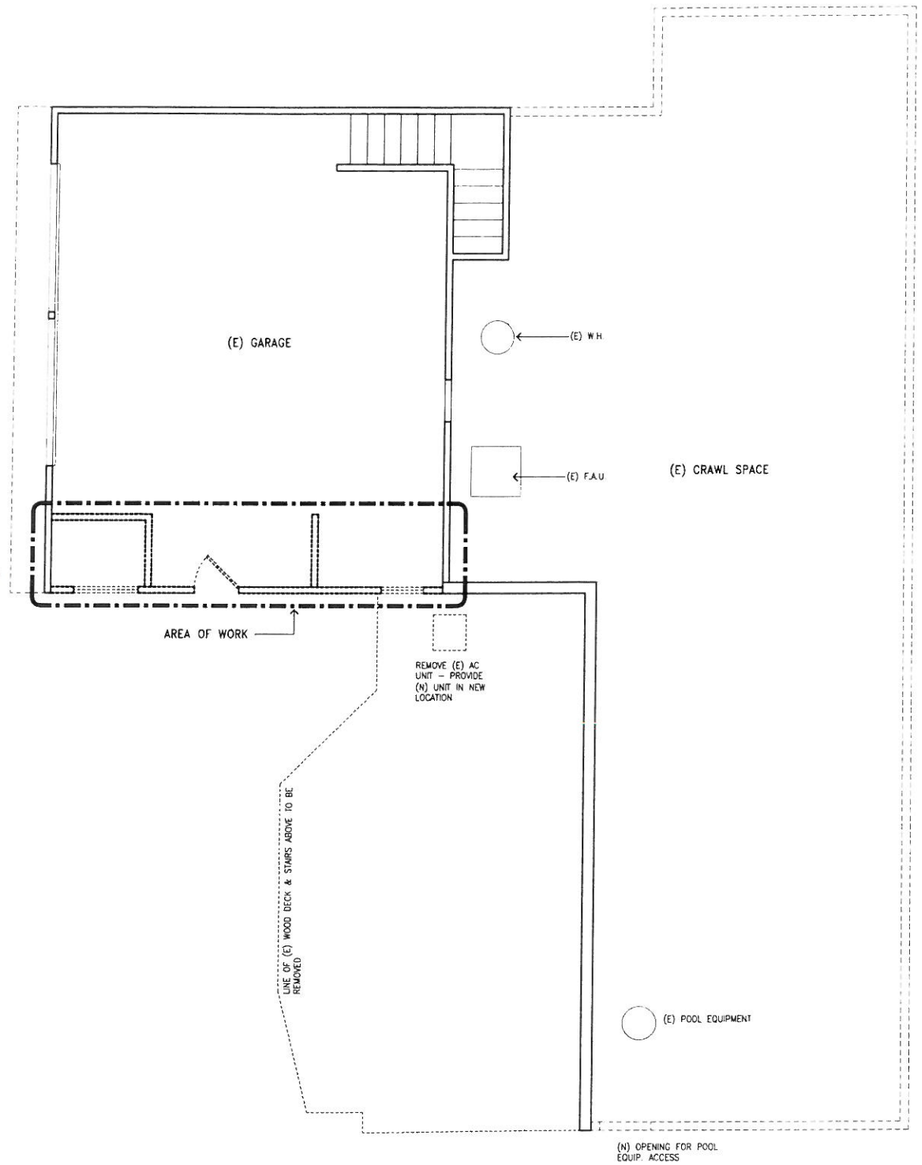


## DEMO LOWER LEVEL

**DEMO LEGEND**

(E) WALL TO REMAIN

REMOVE (E) WALL

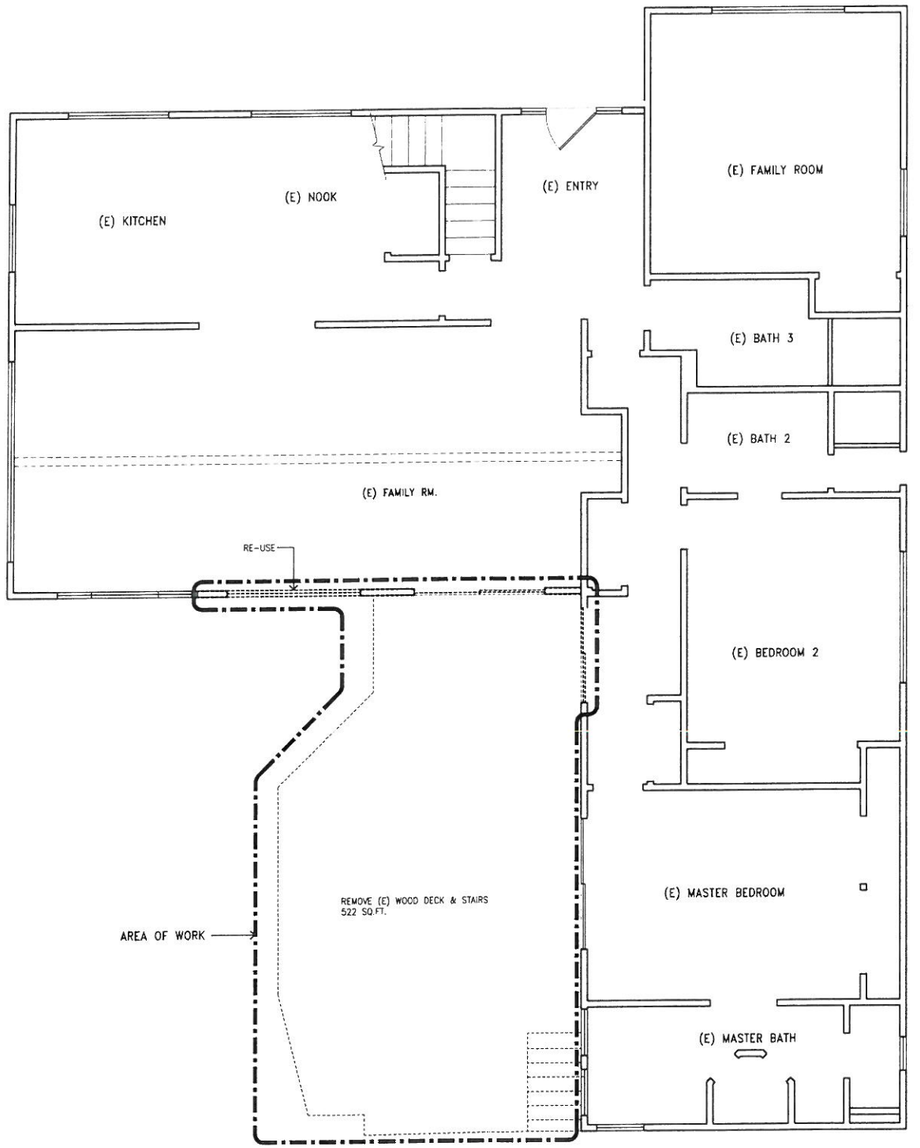


## DEMO MAIN LEVEL

NORTH

LOUIE LEU ARCHITECT INC.
236 N. Santa Cruz Ave., Suite 210, Los Gatos, Ca 95030
Ph. (408) 399-2222 Fax (408) 399-2223 www.louieleuarch.com

LICENSED ARCHITECT * LOUIE LEU * No C15688 31 MAY 2015 RENEWAL DATE * STATE OF CALIFORNIA *

SIGNATURE DATE

Project No. - 2'413

# AZAR RESIDENCE

884 HIGHLANDS CIRCLE, LOS ALTOS, CA 94024

DEMO / NEW LOWER LEVEL PLANS

Scale. - 1/4" = 1'-0"

Date/Revisions:
10-28-14

Sheet No:
A -2.1

© 2015 - LOUIE LEU ARCHITECT INC.

P:\2413-Azar\Drawings\CAD\A2 Floor Plans.dwg - 01.20.2015 - 9:56am

PLANS ARE NOT FOR CONSTRUCTION UNLESS APPROVED AND STAMPED BY BUILDING DEPARTMENT

DESIGN FOR LIVING

P:\21413-Azar\Drawings\CAD\V2 Floor Plans.dwg - 01.20.2015 - 9:57am

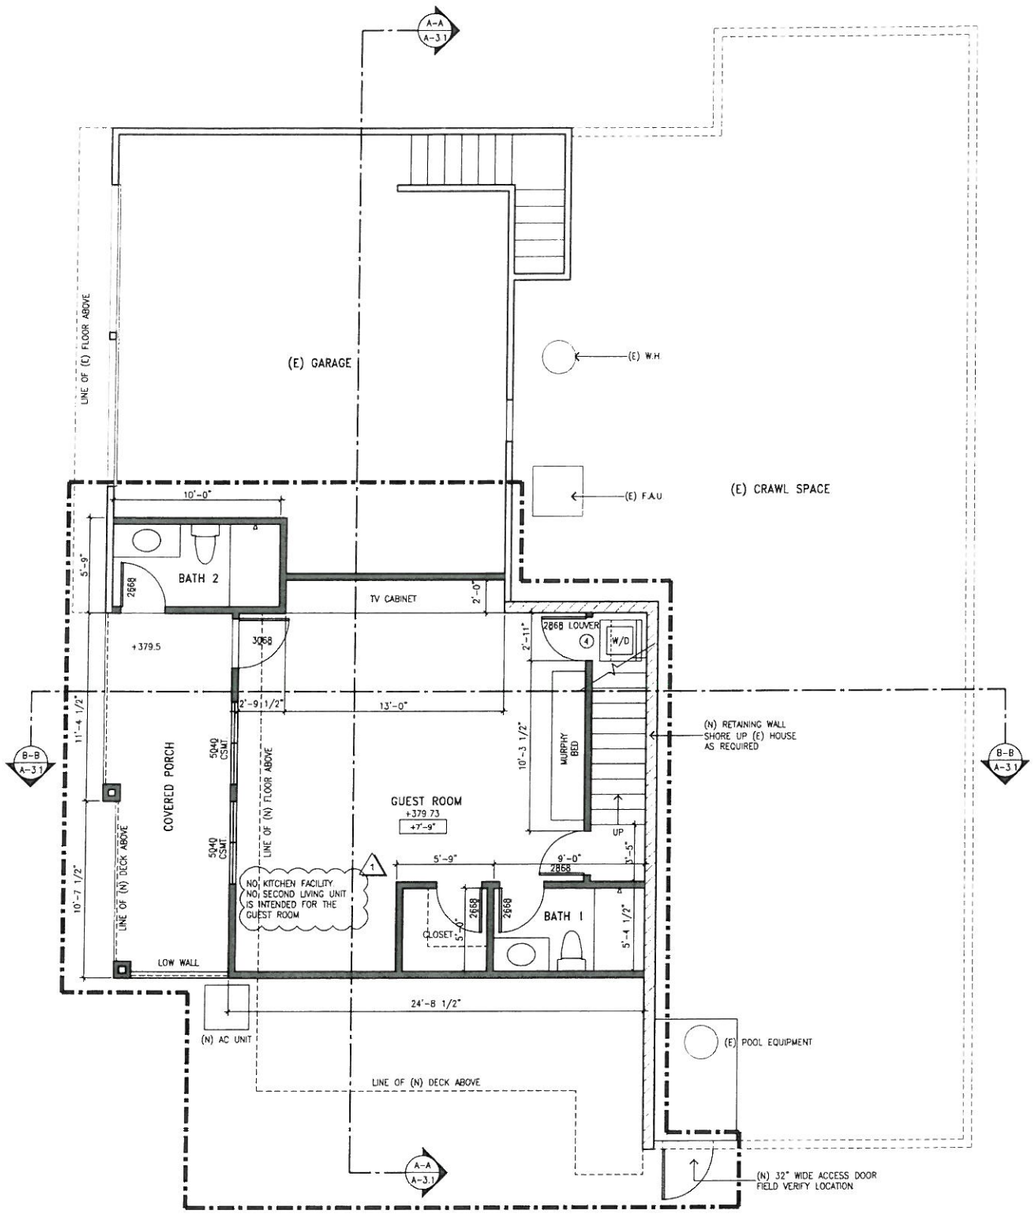


## NEW LOWER LEVEL

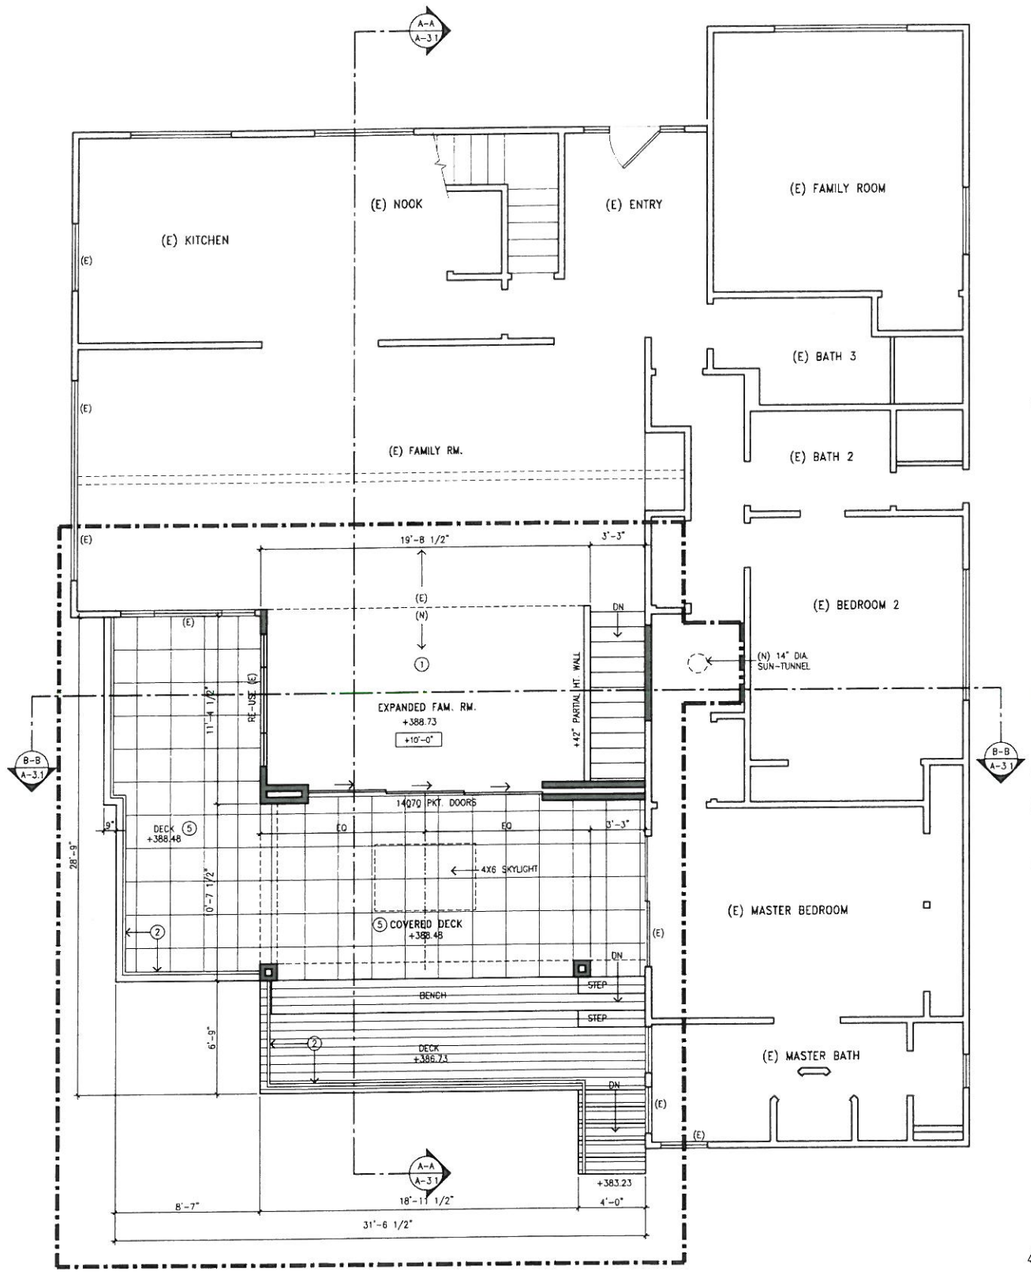


## NEW MAIN LEVEL

### KEY NOTES

1. EXPAND (E) FAMILY ROOM AND ADD STAIR TO (N) GUEST ROOM BELOW
2. DECK GUARDRAIL
3. KITCHENETTE
4. ENCLOSED STAIRWAY PROTECTED ON ALL SIDES BY 5/8" TYPE 'X' GYP. BD.
5. "BISON" PEDESTAL SYSTEM O/ WATERPROOF MEMBRANE. 60 MIL SINGLE PLY PVC ROOF BY IB ROOF SYSTEMS-CLASS'A' RATED COLOR: GRAY

### NEW LEGEND

(E) WALL TO REMAIN

NEW WALL

NORTH


LOUIE LEU ARCHITECT INC

236 N. Santa Cruz Ave., Suite 210, Los Gatos, Ca 95030
Ph (408) 399-2222 Fax (408) 399-2223 www.louieleuarch.com


LICENSED ARCHITECT * LOUIE LEU * No. C15688 31 MAY 2015 RENEWAL DATE * STATE OF CALIFORNIA

Project No - 21413

Scale - 1/4" = 1'-0"

# AZAR RESIDENCE

884 HIGHLANDS CIRCLE, LOS ALTOS, CA 94024

DEMO/NEW MAIN LEVEL FLOOR PLANS

Date/Revisions:
10-28-14
1 01-13-15 PLAN CHECK COMMENTS

Sheet No
A -2.2


© 2015-LOUIE LEU ARCHITECT INC

PLANS ARE NOT FOR CONSTRUCTION UNLESS APPROVED AND STAMPED BY BUILDING DEPARTMENT

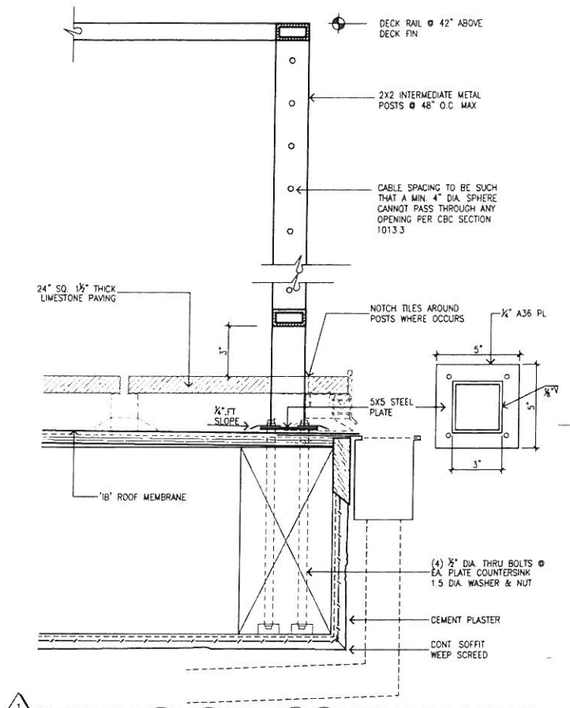


1

**A DETAIL @ GUARDRAIL**
Deck-cantilever-2x2posts 3" = 1'-0"

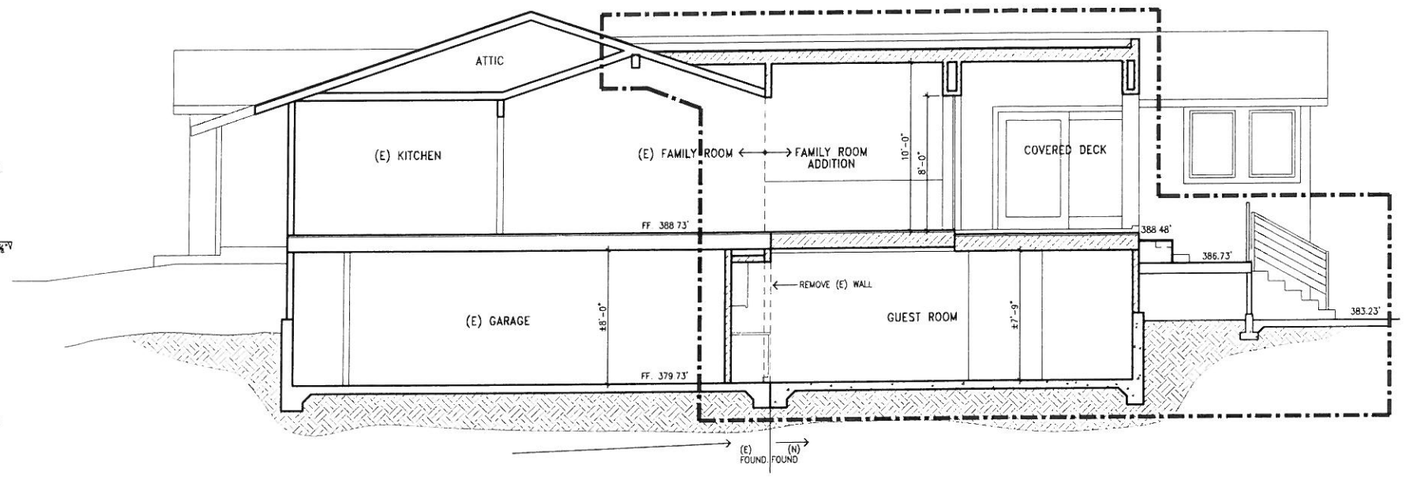


**SECTION A**

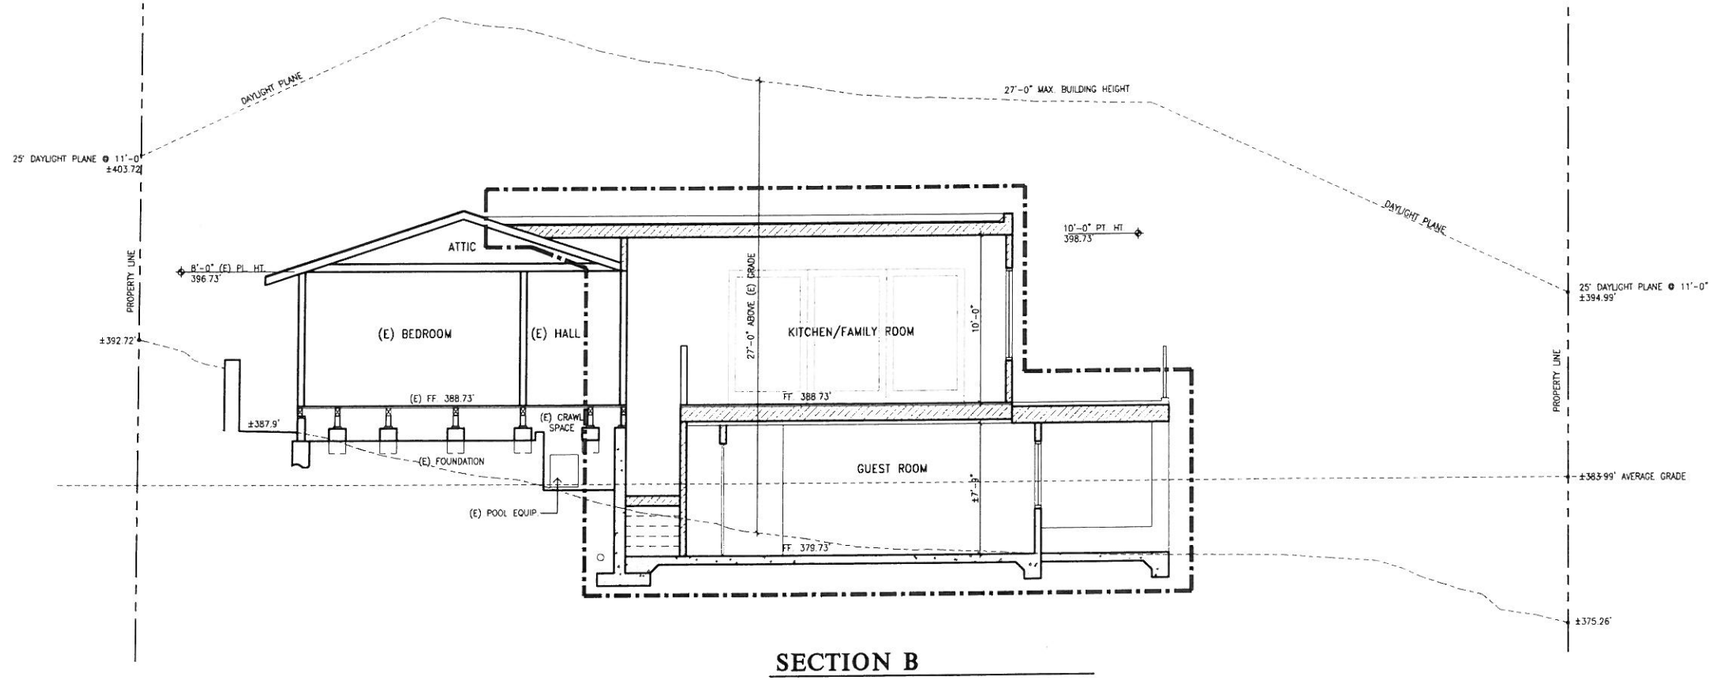


**SECTION B**

LOUIE LEU ARCHITECT INC
236 N. Santa Cruz Ave., Suite 210, Los Gatos, Ca 95030
Ph. (408) 399-2222 Fax (408) 399-2223 www.louieleuarch.com

LICENSED ARCHITECT LOUIE LEU No. C15688 31 MAY 2015 RENEWAL DATE STATE OF CALIFORNIA

SIGNATURE DATE

Project No - 21413

# AZAR RESIDENCE

884 HIGHLANDS CIRCLE, LOS ALTOS, CA 94024

## SECTIONS

Scale - 1/4" = 1'-0"

Date/Revisions:
10-28-14
1 01-13-15 PLAN CHECK COMMENTS

Sheet No:
A - 3.1

© 2015-LOUIE LEU ARCHITECT INC.

PLANS ARE NOT FOR CONSTRUCTION UNLESS APPROVED AND STAMPED BY BUILDING DEPARTMENT

DESIGN FOR LIVING

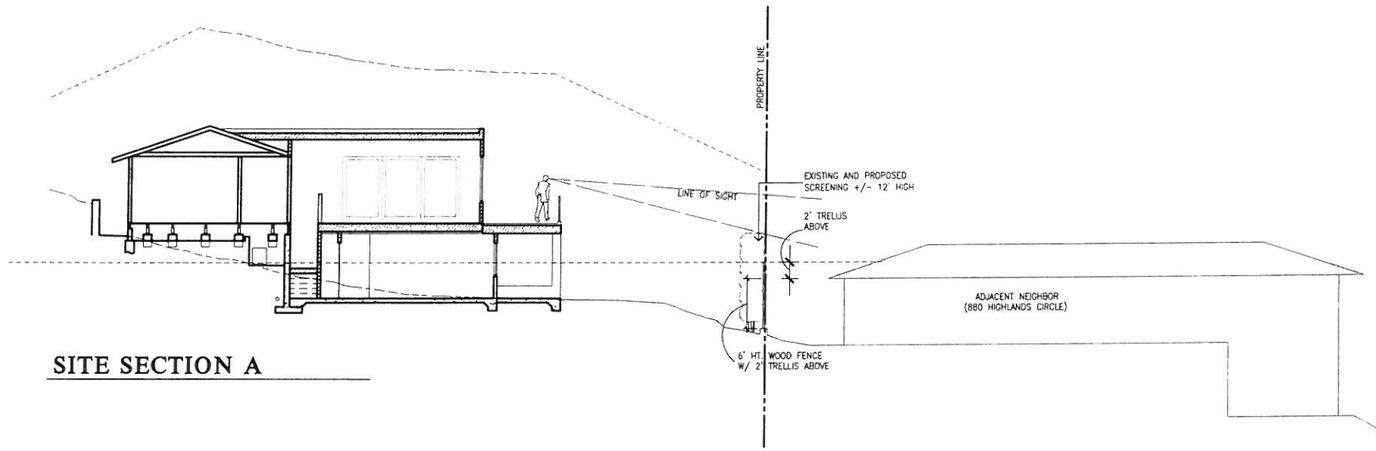


## SITE SECTION A

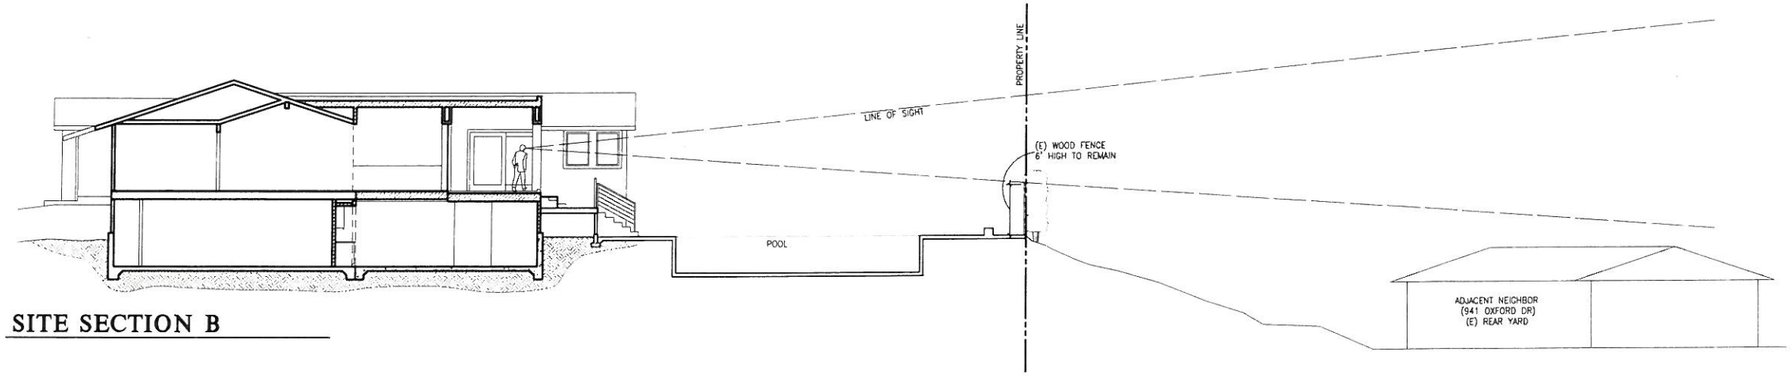


## SITE SECTION B

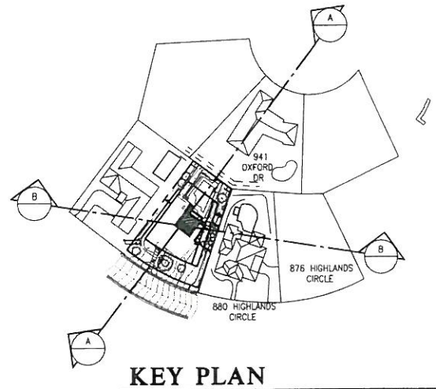


## KEY PLAN

LOUIE LEU ARCHITECT INC.
236 N. Santa Cruz Ave., Suite 210, Los Gatos, Ca 95030
Ph. (408) 399-2222 Fax (408) 399-2223 www.louieleuarch.com

LICENSED ARCHITECT * LOUIE LEU * No. C15688 * STATE OF CALIFORNIA
RENEWAL DATE: 31 MAY 2015
SIGNATURE DATE:

Project No - 21413

# AZAR RESIDENCE

884 HIGHLANDS CIRCLE, LOS ALTOS, CA 94024

## SECTIONS

Scale: - 1/4" = 1'-0"

Date/Revisions:
10-28-14
1 01-13-15 PLAN CHECK COMMENTS

Sheet No.
A - 3.2

© 2015-LOUIE LEU ARCHITECT INC.

P:\21413-Azar\Drawings\CAD\A3-Sections.dwg - 01.20.2015 - 10:00am

PLANS ARE NOT FOR CONSTRUCTION UNLESS APPROVED AND STAMPED BY BUILDING DEPARTMENT

DESIGN FOR LIVING

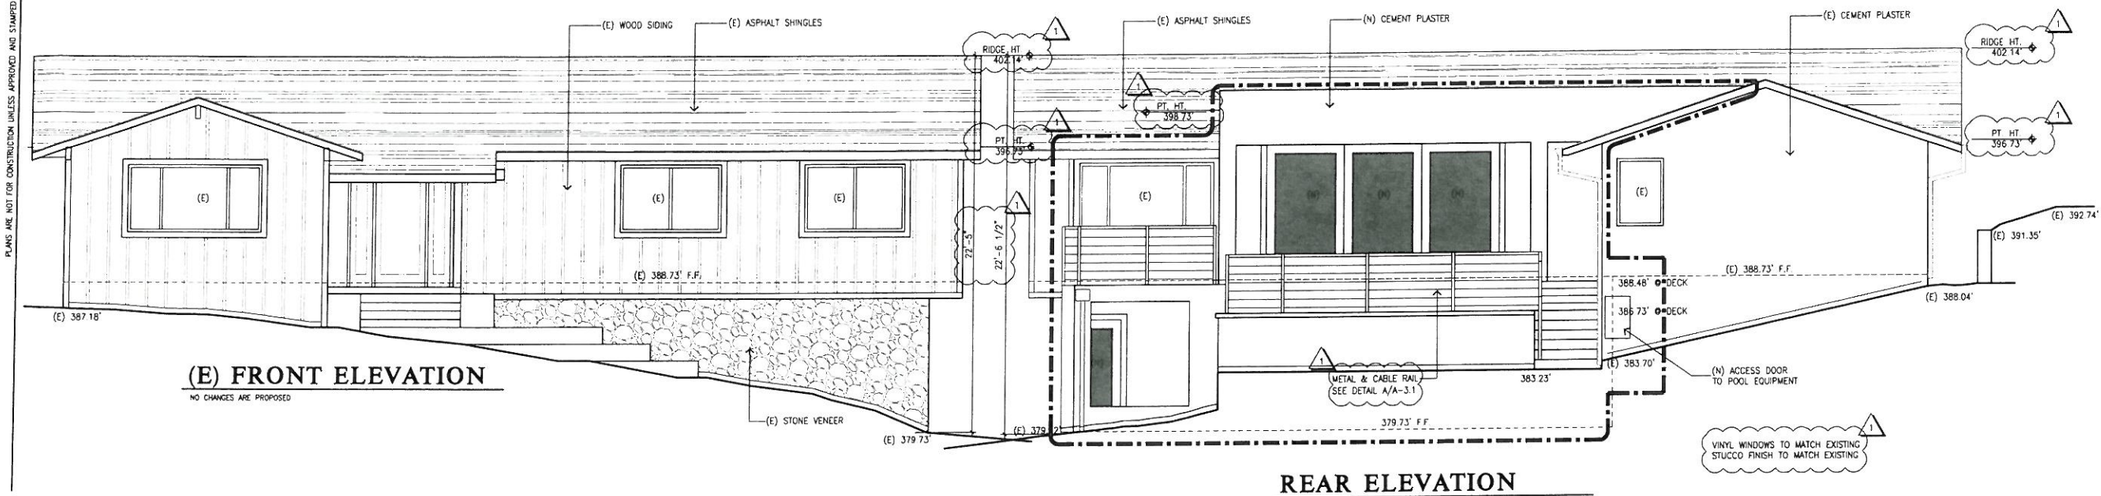


## (E) FRONT ELEVATION

NO CHANGES ARE PROPOSED

## REAR ELEVATION

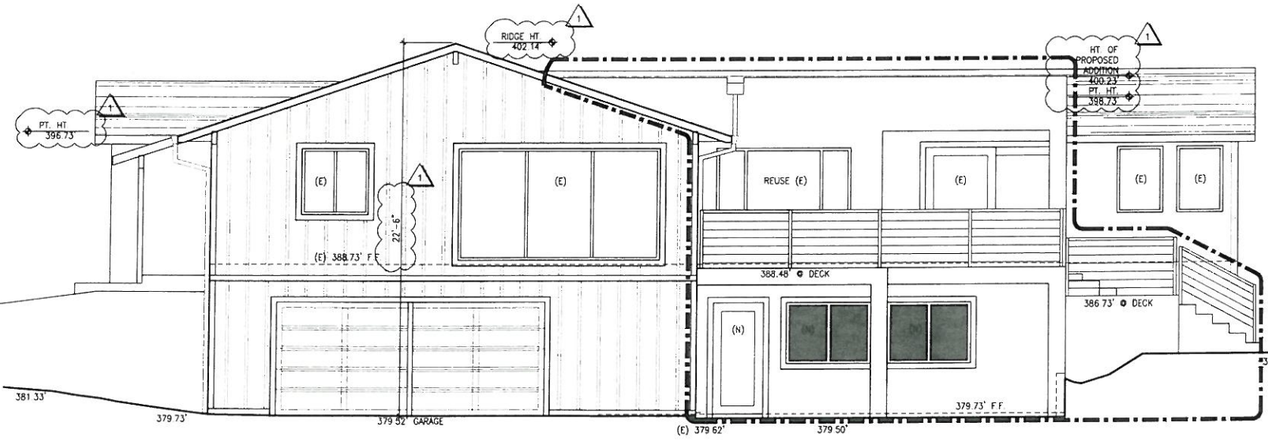


## SIDE ELEVATION

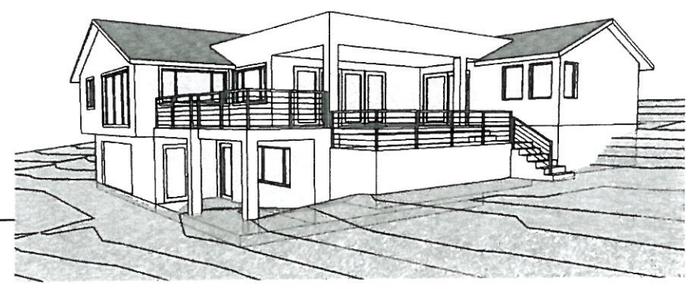

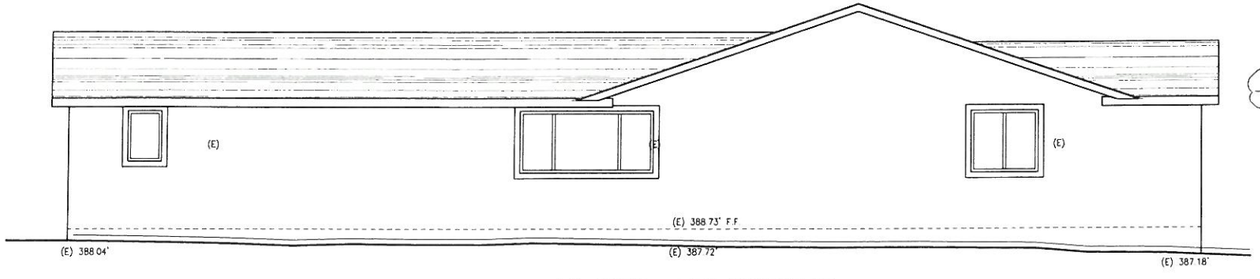


## (E) SIDE ELEVATION

NO CHANGES ARE PROPOSED

PT. HT. 396.73'

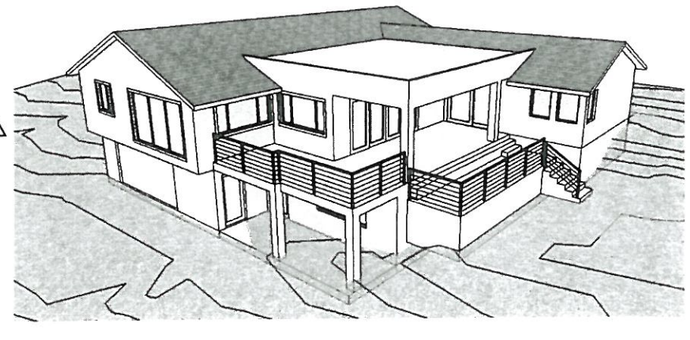

LOUIE LEU ARCHITECT INC
236 N Santa Cruz Ave . Suite 210. Los Gatos, Ca 95030
Ph. (408) 399-2222 Fax (408) 399-2223 www.louieleuarch.com

LICENSED ARCHITECT LOUIE LEU No. C15688 31 MAY 2015 RENEWAL DATE STATE OF CALIFORNIA

SIGNATURE DATE

Project No. - 21413

# AZAR RESIDENCE

884 HIGHLANDS CIRCLE, LOS ALTOS, CA 94024

ELEVATIONS

Scale - 1/18" = 1'-0"

| Date/Revisions. |
|---|
| 10-28-14 |
| 1 01-13-15 PLAN CHECK COMMENTS |

Sheet No

A - 4.1

© 2015-LOUIE LEU ARCHITECT INC.

P:\21413-Azar\Drawings\CAD\A1-Elevations.dwg - 01.28.2015 - 11:58am

PLANS ARE NOT FOR CONSTRUCTION UNLESS APPROVED AND STAMPED BY BUILDING DEPARTMENT

DESIGN FOR LIVING

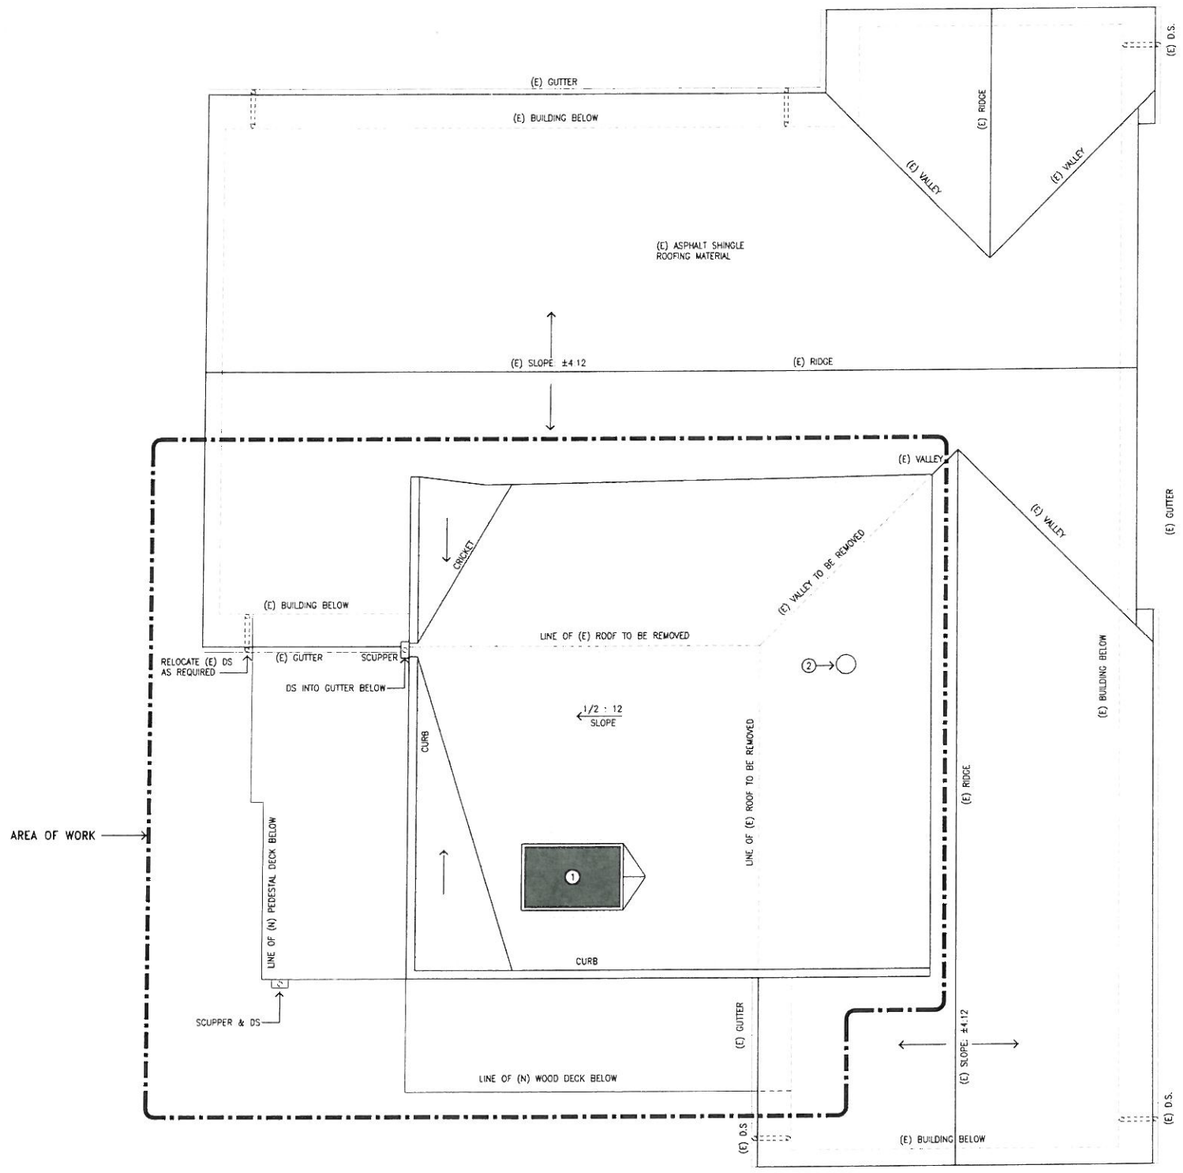


## ROOF PLAN

### KEY NOTES

1. FIXED SKYLIGHT BY SUNOPTICS 48" X 72" TESTING #CCRR-0113
2. 14" DIAMETER SUN TUNNEL

### LEGEND

(N) ROOF AREA
PVC MEMBRANE ROOF
BY "IB" ROOF SYSTEMS
80 MIL THICK, CLASS A

NORTH


LOUIE LEU ARCHITECT INC

236 N Santa Cruz Ave., Suite 210, Los Gatos, Ca 95030
Ph. (408) 399-2222 Fax (408) 399-2223 www.louieleuarch.com


LICENSED ARCHITECT LOUIE LEU No. C15688 31 MAY 2015 RENEWAL DATE STATE OF CALIFORNIA

SIGNATURE DATE

Project No. - 21413

AZAR RESIDENCE

884 HIGHLANDS CIRCLE, LOS ALTOS, CA 94024

ROOF PLAN

Scale - 1/4" = 1'-0"

Date/Revisions
10-28-14

Sheet No:
A -5.1


© 2015- LOUIE LEU ARCHITECT INC.


P:\21413-Azar\Drawings\CAD\A5-Roof.dwg - 01.20.2015 - 9:58am

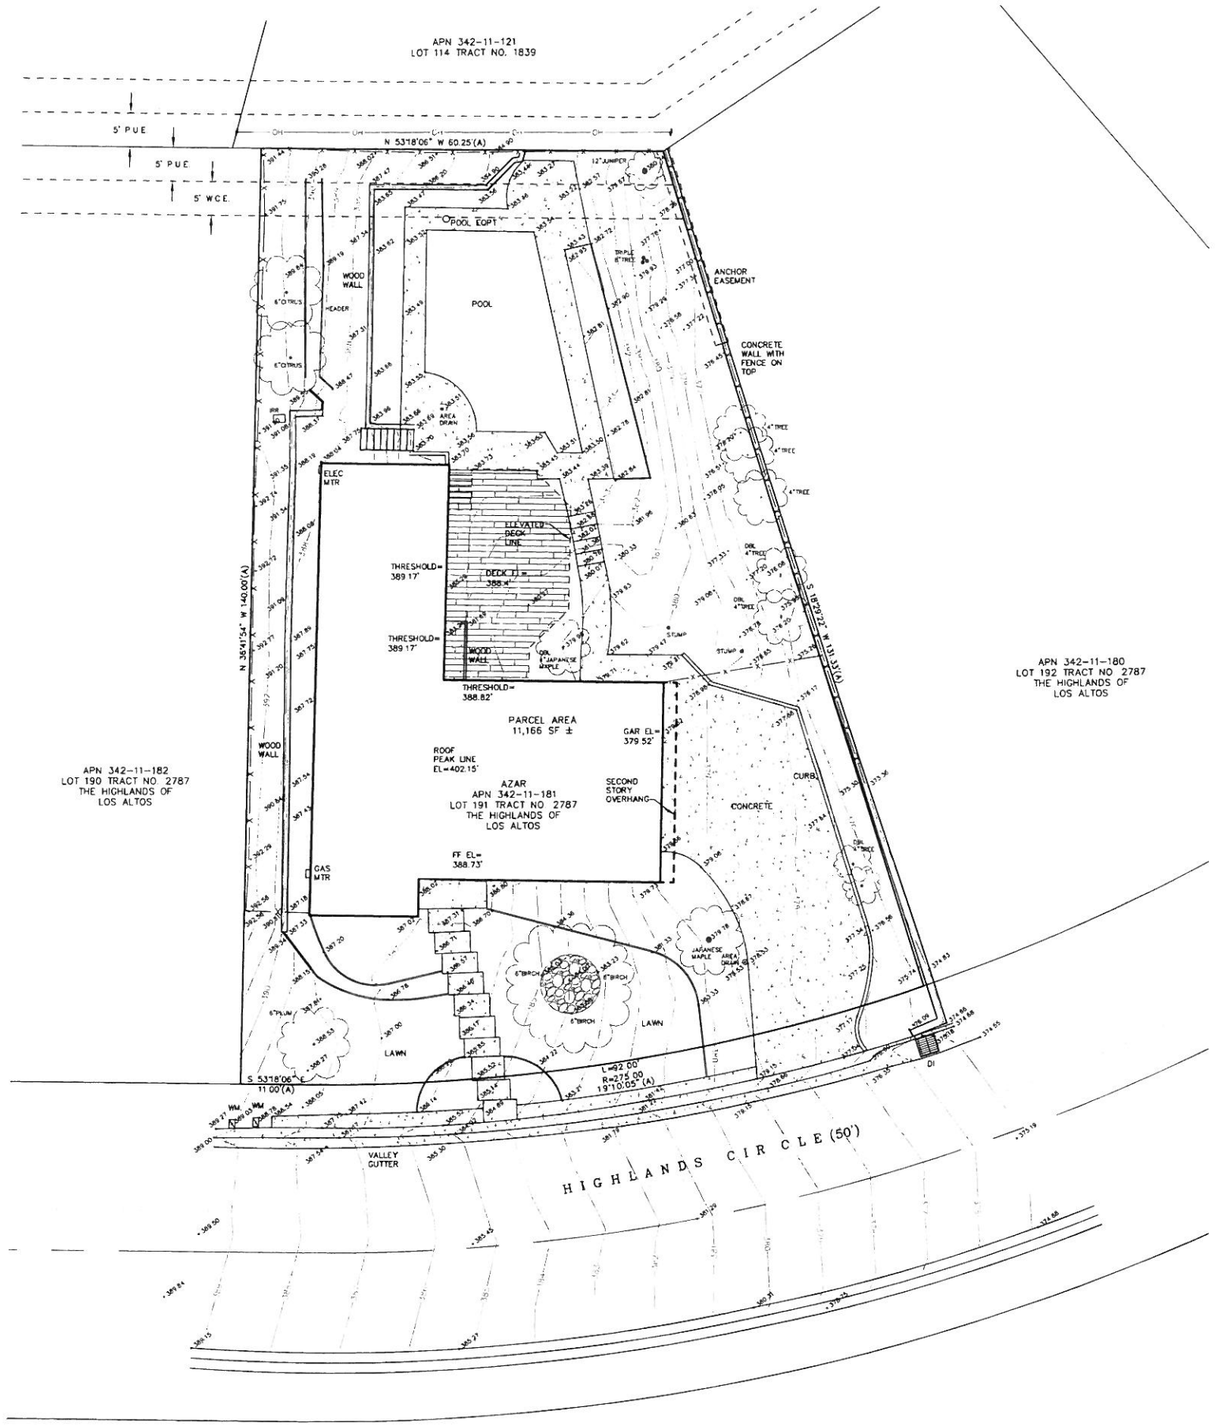


NOTES

A TITLE REPORT WAS NOT PROVIDED FOR THIS SURVEY. EASEMENTS SHOWN ARE COMPILED FROM RECORD MAPS AND THE CURRENT DEED FOR THE PROPERTY. THERE MAY BE ADDITIONAL EASEMENTS THAT BURDEN OR BENEFIT THE SUBJECT PROPERTY THAT WOULD ONLY BE REVEALED ON A TITLE REPORT.

ELEVATION DATUM

ELEVATIONS WERE DERIVED USING AN GPS OBSERVATION AND ARE BASED UPON THE NORTH AMERICAN VERTICAL DATUM OF 1988 (NAVD88).

BASIS OF BEARINGS

BEARINGS ARE BASED UPON THE CENTER LINE OF HIGHLANDS CIRCLE AS SHOWN ON THAT CERTAIN MAP RECORDED IN BOOK 149 OF MAPS AT PAGE 40, SANTA CLARA COUNTY RECORDS

SOUTH 53° 18' 06" EAST

REFERENCES

(A) 149-M-40

SCALE

10 0 5 10 20 40

( IN FEET )
1 inch = 10 ft.

LICENSED LAND SURVEYOR
JEAN-PAUL HAPPEE
8807
STATE OF CALIFORNIA

JEAN-PAUL HAPPEE, PLS 8807

| ALPHA LAND SURVEYS, INC. | | | |
|---|---|---|---|
| 4444 SCOTTS VALLEY DR #7<br>SCOTTS VALLEY, CA 95066<br>(831) 438-4453 | P.O. BOX 1146<br>MORGAN HILL, CA 95038<br>(831) 438-4453 | MAP OF<br>884 HIGHLANDS CIRCLE | SHEET<br>1 |
| 1" = 10 | DATE: 4/15/2014 | JOB#: 2014-030 | LOS ALTOS, SANTA CLARA COUNTY | OF ONE |

# SHRUB AND TREE TABLE

**EXISTING TREES AND SHRUBS (note: only trees above 6" diameter are numbered)**

| # | Botanic Name | Common Name | Size | Notes |
|---|---|---|---|---|
| | Front Yard | | | |
| 1 | Prunus sp | Purple Plum | 6" | To remain |
| 2 | Betula pendula | White Birch | 6" | To remain and be protected |
| 3 | Betula pendula | White Birch | 6" | To remain and be protected |
| 4 | Betula pendula | White Birch | 6" | To remain and be protected |
| 5 | Acer japonicum | Japanese Maple | Multi | To remain |
| | Callistemon citrinus | Bottlebrush | several | To remain |
| | Rear Yard | | | |
| 6 | Malus sp | Fruiting Apple | 4" | poor structure, deciduous, to be removed |
| 7 | Prunus sp | Fruiting Plum | 8" | poor structure, deciduous, to be removed |
| | Pittosporum sp | Pittosporum | (3) 2" | short and old/woody, to be removed |
| 8 | Prunus sp | Fruiting Plum | 6" | poor structure, deciduous, to be removed |
| | Ligustrum sp | Privet | 3" | invasive species, to be removed |
| 9 | Prunus sp | Fruiting Plum | 6" and 4" | poor structure, deciduous, to be removed |
| 10 | Callistemon citrinus | Bottlebrush | 12" | To remain |
| | Cotoneaster sp | Cotoneaster | 3" | invasive species, to be removed |
| 11 | Prunus sp | Plum | 10" | To remain |
| 12 | Juniperus sp. | Juniper | 16" | To remain |
| 13 | Citrus sp | Orange | 8" | To remain |
| 14 | Citrus sp | Orange | 8" | To remain |

**NEW TREES AND SHRUBS**

| SYM | Botanic Name | Common Name | Quantity | Size to install |
|---|---|---|---|---|
| Cc | Caliestemon citrinus | Bottlebrush | 1 | 15 gal |
| Cp | Coleonema pulchrum | Pink Breath of Heaven | 3 | 5 gal |
| Pe | Pittosporum eugenoides | Pittosporum | 8 | 15 gal |

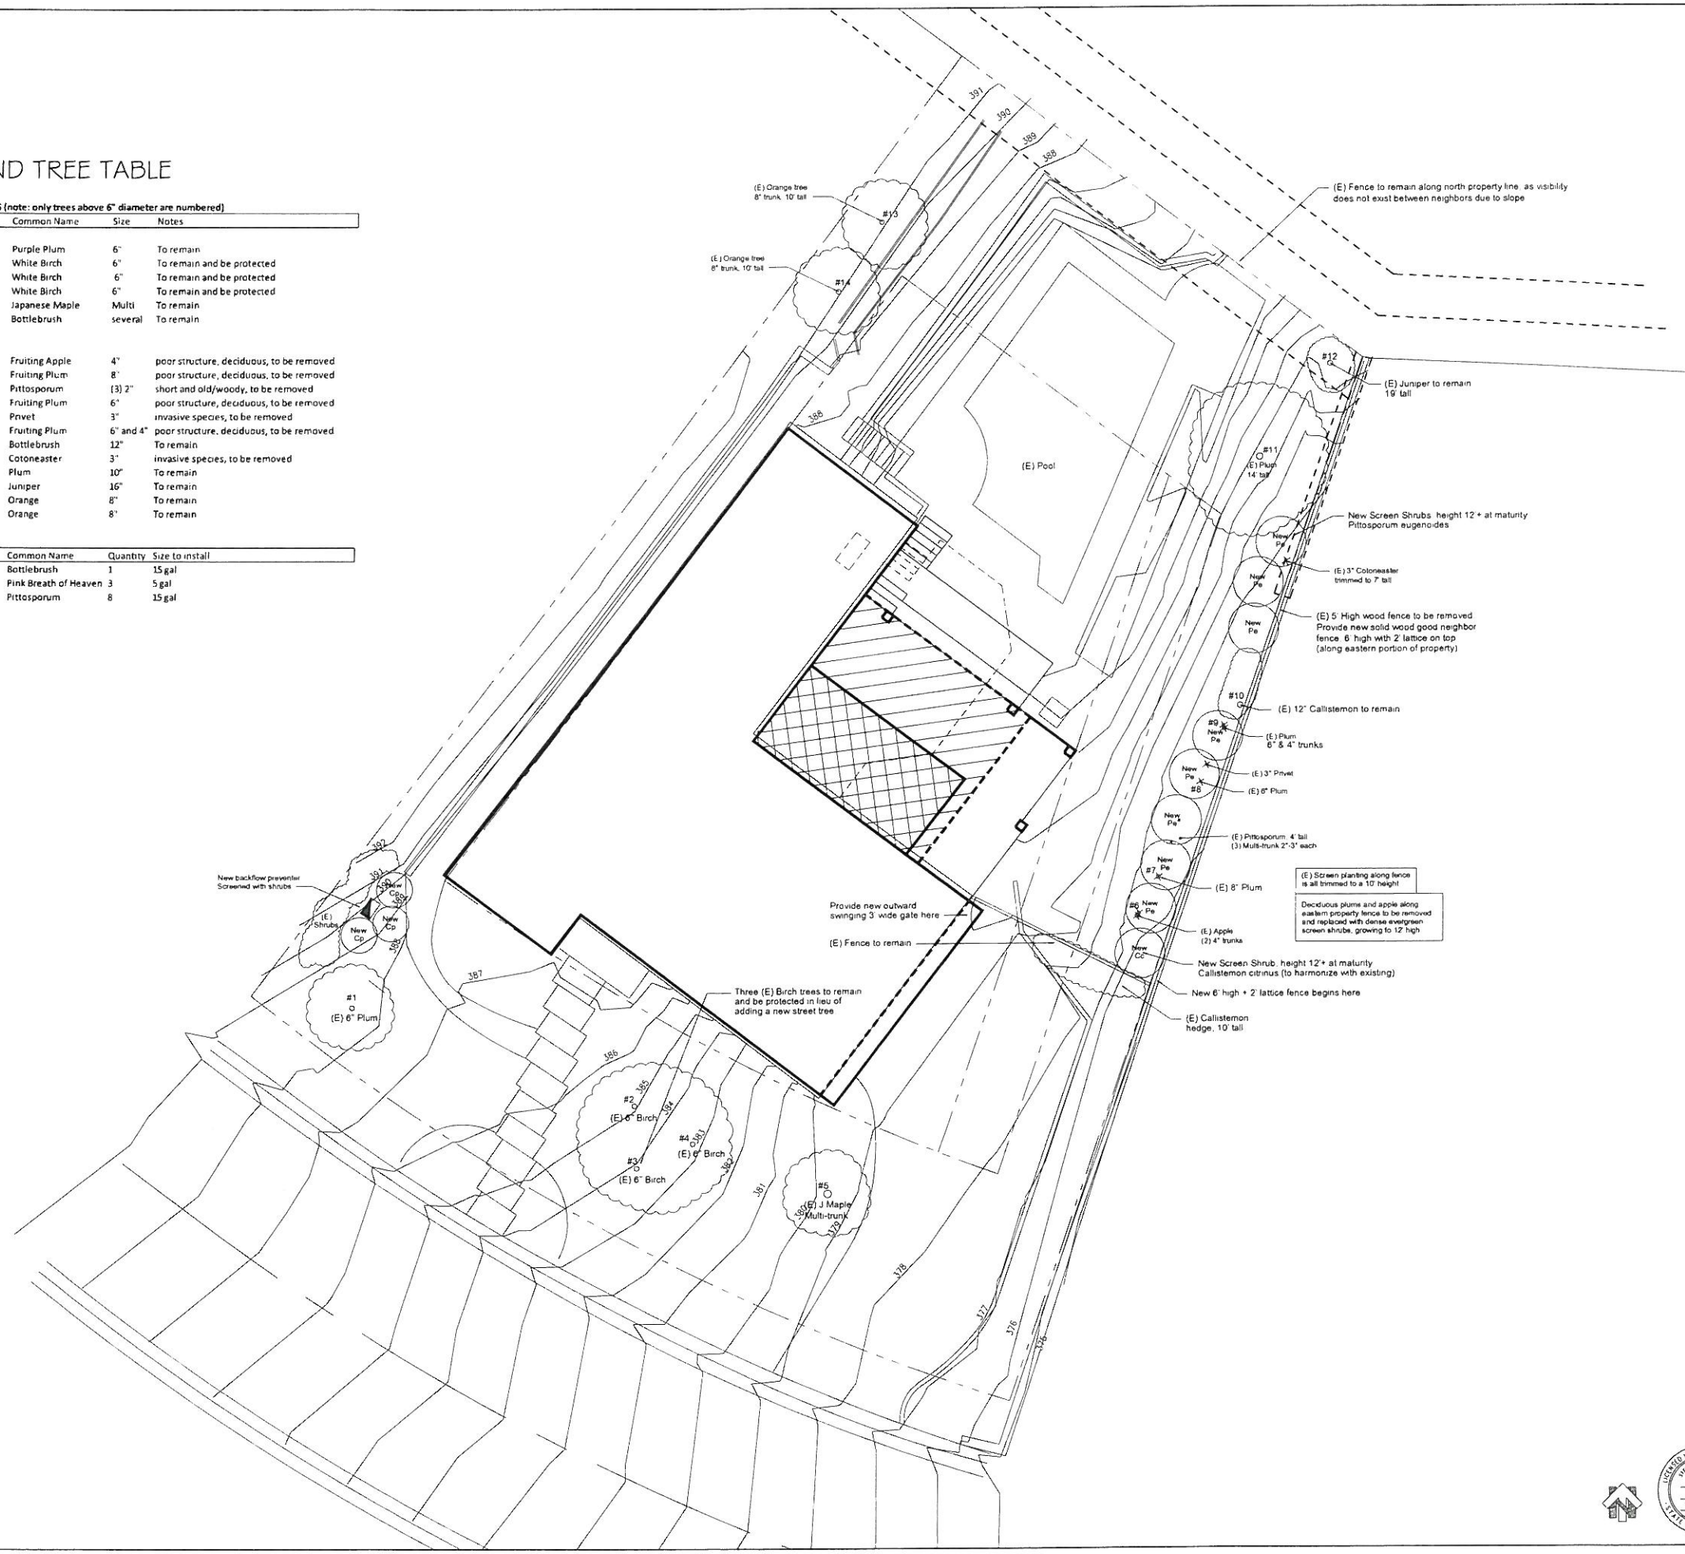



Stephanie L. Morris
Landscape Architect # 4580
www.NativePlantDesign.com
(408) 206-5055


Revised 1/12/15 due to City Comments

Azar Residence
860 Highland Circle
Los Altos, CA 94024

Existing Screen Planting Plan

Scale: 1/8"=1'-0"

Date: 10/30/14
Rev 1/12/15

Sheet # L-1.01

LICENSED LANDSCAPE ARCHITECT
STEPHANIE L. MORRIS
4580
Signature
Business Zone
Date
STATE OF CALIFORNIA